


CERTIFIED RECORD OF LAND CORNER MONUMENTATION

History of original corner establishment:

Corner not previously established.

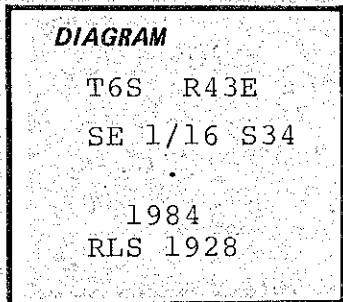

Description of corner evidence found:

Corner not previously established.

Description of monument and accessories I established to perpetuate the original location of this corner:

Set 30" aluminum pipe with 3/4" aluminum cap 12" above ground marked as shown with a rock collar to base of cap.

Steel post set 3' east with signs 54-2 and 54-9.


Scribed:

- 11" Fir "SE1/16 S34 BT" S52E 31.8 ft.
- 8" Fir "SE1/16 S34 BT" N29E 19.7 ft.

Nailed aluminum washers stamped "PLS 1928" above "BT" scribe on both trees.

Nailed bearing tree signs above blaze and a land survey monument sign on back of each tree.

Painted the blazes red and a 6" red band around each tree above blaze.

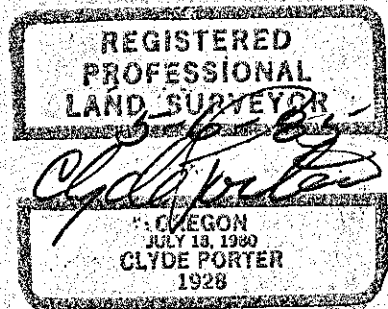

Office of..... County of.....
 State of....., I hereby certify that the within instrument was filed in this office
 for record on the..... day of....., 19.....

(COUNTY OFFICIAL)

(DEPUTY)

FILED May 9 1985
 BAKER COUNTY SURVEYOR
 SURVEY NO. 6-43-112