


CERTIFIED RECORD OF LAND CORNER MONUMENTATION

History of original corner establishment:

Original corner established in 1881 by  
W. B. Barr under Contract #388.  
Set a basalt rock 20" x 15" x 6".  
Scribed:

30" Pine N5E 33 lks  
20" Pine South 25 lks

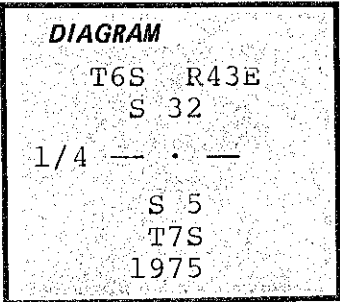

Description of corner evidence found:

B.L.M. remonumented corner in 1975 from original evidence.  
We found a B.L.M. brass cap 8" above ground marked as shown above.  
Found:

37" Pine with illegible markings.  
35" Pine with illegible markings and a 54-4 sign attached.

Description of monument and accessories established to perpetuate the original location of this corner:

Set steel post 3' south of cap with sign 54-9.  
Painted existing bearing trees and attached bearing tree signs to both.



Office of..... County of.....  
State of....., I hereby certify that the within instrument was filed in this office  
for record on the..... day of....., 19.....  
..... by .....

(COUNTY OFFICIAL)

(DEPUTY)

FILED May 9, 1986  
BAKER COUNTY SURVEYOR  
SURVEY NO. 6-43-113