

CERTIFIED RECORD OF LAND CORNER MONUMENTATION


History of original corner establishment:

Original corner established in 1881 by
W. B. Barr under Contract #388.

Set basalt rock 10" x 8" x 8" marked with four
notches on east edge and two notches on west edge.

Scribed:

- 30" Pine N79E 48 lks
- 40" Pine N52W 63 lks
- 18" Fir S65W 40 lks
- 15" Pine S66E 70 lks

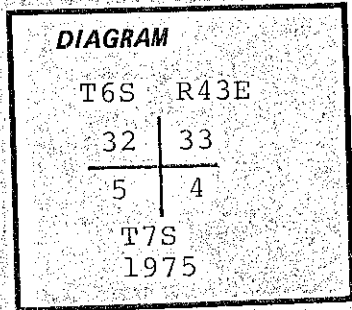

Description of corner evidence found:

Found a B.L.M. brass cap set 22" above ground and a mound of rocks with
a 5½' base to base of cap, marked as shown above.

Found:

- 36" Pine N79E 48 lks Markings visible
- 16" Pine snag S63E 70 lks Markings visible
- 24" Fir S70W 40 lks Markings visible
- 32" Pine snag N48W 63 lks Markings visible
- 10" Pine S60E 41 lks Markings visible
- 23" Pine N76W 69 lks Markings visible

All had 54-3 signs attached.

Description of monument and accessories I established to perpetuate the
original location of this corner:

Painted scribes red and a 6" red band above blaze on all trees.
Attached new signs wherever needed.



Office of..... County of.....
 State of....., I hereby certify that the within instrument was filed in this office
 for record on the..... day of....., 19.....
 by
 (COUNTY OFFICIAL) (DEPUTY)

FILED May 9, 1986
 BAKER COUNTY SURVEYOR
 SURVEY NO. 6-43-114