


CERTIFIED RECORD OF LAND CORNER MONUMENTATION

History of original corner establishment:

Original corner established in 1884 by
W. B. Barr under Contract #503.

Set 4' post 4" in diameter 18" in the ground.
Scribed:

- 8" Fir N60W 23 lks
- 8" Fir S18E 37 lks

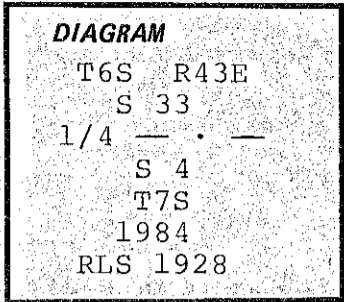

Description of corner evidence found:

None

Description of monument and accessories established to perpetuate the original location of this corner:

Set 30" aluminum pipe with 3 1/4" aluminum cap 5" above ground marked as shown above.


Steel post 3' north with sign 54-9 attached and scribed:

- 17" Fir "1/4 S33 BT" N25E 35.6 ft.
- 12" Fir "1/4 S4 BT" S52E 68.5 ft.

Nailed aluminum washers stamped "PLS 1928" above "BT" scribe on both trees.

Nailed bearing tree signs above blazes and land survey monument signs on back of each tree.

Painted blazes red and a 6" red band above blaze on both trees.

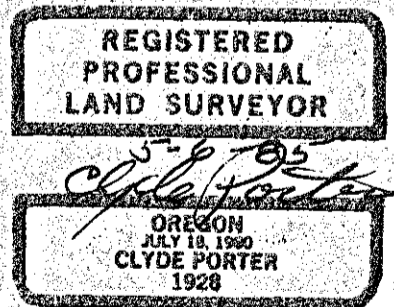

Office of..... County of.....

State of..... I hereby certify that the within instrument was filed in this office for record on the..... day of..... 19....

(COUNTY OFFICIAL)

(DEPUTY)

FILED May 9, 1986
 BAKER COUNTY SURVEYOR
 SURVEY NO. 6-43-115