

CERTIFIED RECORD OF LAND CORNER MONUMENTATION


R-1

History of original corner establishment:

W. B. Barr conducted the survey of Township 6 South, Range 42 East, W.M., May 29 to June 26, 1882, under GLO Contract No. 443, dated May 29, 1882. (Exterior lines only under this contract).

For the corner point a basalt rock 14" x 6" x 6", set 9 ins. into the ground marked with 4 notches on the North and 2 notches on the South sides, from which

- A Pine, 14 ins. dia., bears N. 62° E. at 60 lks. dist., mkd. T6S R43E S 19 BT.
- A Pine, 26 ins. dia., bears N. 43° W. at 37 lks. dist., mkd. T6S R42E S 24 BT.
- A Western Larch, 4 ins. dia., bears S. 26° W. at 82 lks. dist., mkd. T6S R42E S 25 BT.
- A Fir, 6 ins. dia., bears S. 21° E. at 6 lks. dist., mkd. T6S R43E S 30 BT.

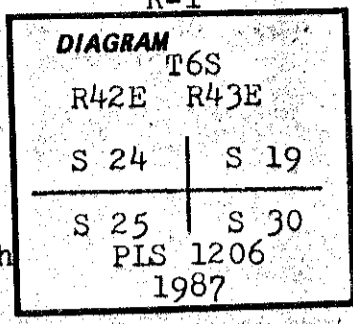

Description of corner evidence found:

- Found an ancient 24" dia. stone mound. Corner stone not identifiable.
- BT's- A live 29" dia. Ponderosa Pine bears N. 67° E. at 40.8 ft. dist. mkd. scribe visible but not legible, blaze is partially healed over.
- A 14" dia. down and partially rotted Douglas Fir, bears S. 21° E. at 43.0 ft. mkd. 6S R42 the rest of the scribe is healed over.
- A root hole bears N. 41° W. at 28.0 ft. dist.
- No evidence of the SW bearing tree for Sec. 25.

Description of monument and accessories established to perpetuate the original location of this corner:

- Set a 2½" x 30" alum. pipe with a 2½" alum. cap 12" into the ground. Constructed a 48" dia. stone mound around the monument. Cap is marked as shown in the corner diagram. Corner was placed in the center of the mound.
- From the corner point: (New BT's)
- A 12" dia. White Fir bears N. 23° W. at 26.6 ft. dist., mkd. T6S R42E S 24 BT.
- A 16" dia. Douglas Fir bears S. 60° W. at 30.6 ft. dist., mkd. T6S R42E S 25 BT.
- A 12" dia. Douglas Fir bears S. 35° E. at 46.3 ft. dist., mkd. T6S R43E S 30 BT.

Set a steel fence post 4 ft. W. from the monument and attached a USFS 54-9 sign. Painted the face of the blaze and a 6 in. band around the bearing trees red. I.D. washers were nailed between the scribed B and T of the new bearing trees. The washers are ¾" in diameter and made of brass with PLS 1206 stamped on one side. Attached USFS 54-9 and 54-3 signs to bearing trees. Used 18½° declination on a staff compass for readings to bearing trees. Used a steel tape to measure to a nail set in the side of the trees.

This corner was monumented to USFS specifications on August 7, 1987, witnessed by Tom Fisk and Andy Marlette.

Office of.....County Surveyor..... County of..... Baker.....
 State of.....OR..... I hereby certify that the within instrument was filed in this office
 for record on the..... day of....., 19.....
 by
 (COUNTY OFFICIAL) (DEPUTY)

Form R6-7100-57 (9/71)

FILED 10/18/88
 BAKER COUNTY SURVEYOR
 SURVEY NO. 6-42-1
6-43-118

**REGISTERED
PROFESSIONAL
LAND SURVEYOR**

James D. Hanley

OREGON
SEPTEMBER 21, 1971
JAMES D. HANLEY
 1206