


CERTIFIED RECORD OF LAND CORNER MONUMENTATION

R-3

History of original corner establishment:

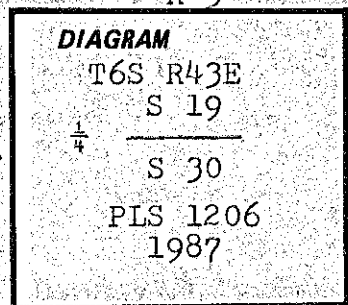

W. B. Barr conducted the survey of Township 6 South, Range 43 East, W.M., July 11, to July 29, 1884, under GLO Contract No. 503, dated May 23, 1884.

For the corner point Barr used a 33 in. dia. Pine.

From the corner point:

- A 6" dia. Pine bears N. 72° E. at 17 lks. dist.
- A 24" dia. Pine bears S. 17° E. at 70 lks. dist.

Description of corner evidence found:

Found a 36" dia. rotted stump at the corner point.

BT's-

A 18" dia. live Ponderosa Pine bears N. 59° E. at 11.8 ft. dist., mkd.  $\frac{1}{4}$ , the rest of the blaze is healed over.

A 37" dia. live Ponderosa Pine bears S. 2° E. at 49.3 ft. dist., mkd. blaze is healed over.

Description of monument and accessories established to perpetuate the original location of this corner:

In the center of the original corner tree stump remains:

Set a 2½" x 30" alum. pipe with a 2½" alum. cap 28" into the ground. Constructed a 36" dia. stone mound around the monument. The cap is marked as shown in the corner diagram. From the corner point:

Piled the remains of the original corner stump 10' South of the monument.

Set a steel fence post 4 ft. from the monument and attached a USFS 54-9 sign. Painted the face of the blaze and a 6 in. band around the bearing trees red. Attached USFS 54-9 and 54-3 signs to the bearing trees. Used 18½° declination on a staff compass for readings to bearing trees.

This corner was monumented to USFS specifications on August 7, 1987, witnessed by Tom Fisk and Andy Marlette.

Office of.....County Surveyor.....County of.....Baker.....  
 State of.....OR....., I hereby certify that the within instrument was filed in this office  
 for record on the.....day of....., 19.....  
 .....by.....  
 (COUNTY OFFICIAL) (DEPUTY)

Form R6-7100-57 (9/71)

FILED 10/18/88  
 BAKER COUNTY SURVEYOR  
 SURVEY NO. 6-43-119

