


CERTIFIED RECORD OF LAND CORNER MONUMENTATION

V-3

History of original corner establishment:

W. B. Barr conducted the survey of Township 6 South, Range 43 East, W.M., July 11 to July 29, 1884, under GLO Contract No. 503, dated May 23, 1884.

For the corner point Barr set a volcanic rock 16 ins. x 10 ins. x 8 ins., 11 ins. into the ground, with 1/4 chiseled into it.

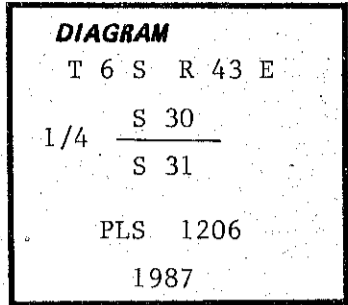

From the corner point:

- A 26 ins. diam. Pine bears S. 65° E., 52 lks. dist.
- A 18 ins. diam. Pine bears N. 46° E., 77 lks. dist.

Description of corner evidence found:

Found a 30 ins. diam. Ponderosa pine bearing N. 46° E., 50.8 ft. dist., mkd. 4S T, The rest of the scribe has healed over. Tree is alive and healthy.

Description of monument and accessories established to perpetuate the original location of this corner:

Set a 2 1/2 in. x 30 in. alum. pipe with a 2 1/2 in. alum. cap, 22 ins. into the ground. Constructed a 36 in. stone mound around the monument. The cap is marked as shown in the corner diagram. Corner was reestablished using record bearing and distance from the original BT.

From the corner point:

A 9 ins. diam. Ponderosa pine bears S. 42° E., 23.3 ft. dist., mkd. 1/4 S 31 BT.

Set a steel fence post 4 ft. North from the monument and attached a USFS 54-9 sign. Painted the face of the blaze and a 6 in. band around the bearing trees red. I.D. washer was nailed between the scribed B and T of the new bearing tree. The washer is 3/4 in. diameter and made of brass, with PLS 1206 stamped on one side. Attached USFS 54-9 and 54-3 signs to bearing trees. Used 18 1/2° declination on a staff compass for readings to bearing trees. Used a steel tape to measure to a nail set in the side of the new bearing tree.

This corner was monumented to USFS specifications on July 2, 1988., witnessed by Tom Fisk and Andy Marlette.

The monument had been previously set August 10, 1987, using an erroneous 58.8 ft. distance. Correct reestablishment with 50.8 ft. distance was subsequently made on July 2, 1988, by moving the monument 8.0 feet.

Office of..... County Surveyor..... County of..... Baker
 Oregon
 State of....., I hereby certify that the within instrument was filed in this office
 for record on the..... day of....., 19.....
 by
 (COUNTY OFFICIAL) (DEPUTY)

Form R6-7100-57 (9/71)

FILED 10/18/88
 BAKER COUNTY SURVEYOR
 SURVEY NO. 6-43-120

