


CERTIFIED RECORD OF LAND CORNER MONUMENTATION

Y-24

History of original corner establishment:

Corner established by W.L. Hanley and recorded under Baker County Survey No. 7-44-11, filed October 4, 1978. Record of Survey states: Set 5/8 inch x 30 inch rebar. On Nov. 15, 1984 this corner was remonumented by W.L. Hanley, PLS 1639, with a 2 1/2" aluminum cap on 2" aluminum pipe 31" long, buried 27" in ground and surrounded by rock mound. A 6' steel fence post alongside with sign 54-9 attached. Buried rebar alongside. Aluminum cap marked as shown in diagram. New Bearing Trees established:

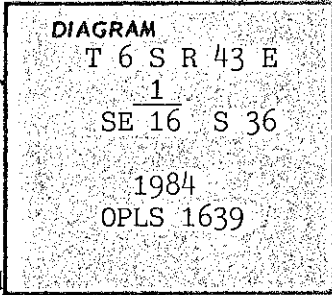

A fir 8 ins dia bears North, 38.0 ft marked SE1/16S36 BT
A fir 14 ins dia bears N42°E, 15.2 ft marked SE1/16S36 BT

Each bearing tree has a brass washer marked PLS 1639 nailed flush with BT blaze and has signs 54-3 and 54-9 attached below a 6 inch band of red paint.

Description of corner evidence found:

Found a 2" aluminum pipe with a 2 1/2" aluminum cap marked as shown in diagram, 4 inches above ground level, surrounded by a mound of stone. A 6 foot steel fence post with 54-9 sign attached alongside monument. Found bearing trees of record live and vigorous at record bearing and distance, marked and signed as per record.

Description of monument and accessories established to perpetuate the original location of this corner

The bearing trees of record are within the clearing limits of new road construction and will be removed. Established the following new bearing trees:


A White Fir, 10 inches in diameter, bears N40W, 65.7 feet, scribed SE1/16S36 BT, on a single blaze.

A White Fir, 9 inches in diameter, bears N66°E, 70.3 feet, scribed SE1/16S36 BT, on a single blaze.

Each new bearing tree has a brass washer marked PLS 1636 nailed flush between the B and T scribes and has signs 54-3 and 54-9 attached below a 6 inch band of red paint. Blazes are painted red.

I hereby certify that the above described bearing trees were properly established by me on September 29, 1987 and witnessed by Susan E. Newstetter and Janet Eggers.

Magnetic Declination: 19 1/2° East

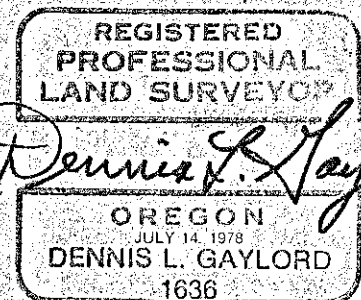

Office of County Surveyor County of Baker
State of Oregon I hereby certify that the within instrument was filed in this office
for record on the day of
..... by
(COUNTY OFFICIAL) (DEPUTY)

FILED 10-26-87
BAKER COUNTY SURVEYOR
SURVEY NO. 6-43-121