

CERTIFIED RECORD OF LAND CORNER MONUMENTATION


History of original corner establishment:

Corner established by W. B. Barr under G L O contract No. 503, dated May 23, 1884.

Surveyor's General records state:

Set a basalt rock 14x8x6 ins, 10 inches in the ground for 1/4 sec cor marked 1/4 on N side, from which:

A fir, 4 ins diam bears N 26° E, 12 lks dist marked 1/4 S BT
 A fir, 4 ins diam bears S 14° W, 16 lks dist marked 1/4 S BT

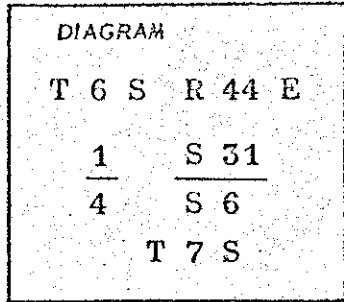

Description of corner evidence found:

None

Description of monument and accessories established to perpetuate the original location of this corner:

Set a 2½ inch brass cap on a 1 inch iron pipe, 31 inches long, 26 inches in the ground to bedrock with a surrounding dirt and rock mound, from which

New Bearing trees:

A fir, 12 ins diam bears N 04° W, 47.2 ft dist marked 1/4 S 31 BT
 A pine, 16 ins diam bears S 10° E, 52.8 ft dist marked 1/4 S 6 BT

Brass cap marked thus: T 6 S R 44 E

<u>1</u>	<u>S 31</u>
4	S 6
	T 7 S

1978

ORLS 1206

REGISTERED
PROFESSIONAL
LAND SURVEYOR

William L. Hanley

OREGON
JULY 14, 1978
WILLIAM L. HANLEY
1639

I hereby certify that the above corner monument was properly established on July 31, 1978 witnessed by B. Hanley, R. Spivey, and J. DeMastus.

Office of County Surveyor..... County of Baker
 State of Oregon..... I hereby certify that the within Instrument was filed in this office
 for record on the day of

(COUNTY OFFICIAL)

(DEPUTY)

FILED Aug. 11, 1978
 BAKER COUNTY SURVEYOR
 SURVEY NO. 7-44-9
6-44-2
 Form R6-7100-57 (9/71)