

CERTIFIED RECORD OF LAND CORNER MONUMENTATION


History of original corner establishment:

Corner established by W. B. Barr under GLO contract no. 503 dated May 23, 1884.

Surveyor's General records state:

Set slatestone 18 x 16 x 6 ins. 12 ins. in the ground for 1/4 sec cor marked 1/4 on the N side from which:

- A pine 7 ins. diam. bears S 74° W, 70 lks. dist. marked 1/4 S BT
- A pine 6 ins. diam. bears N 85° E, 67 lks. dist. marked 1/4 S BT

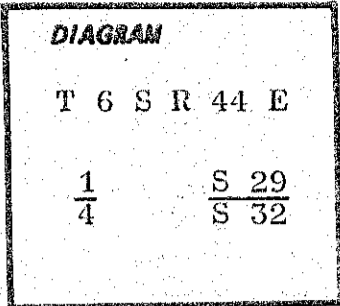

Description of corner evidence found:

None-Corner re-established by single proportionate measure.

Description of monument and accessories established to perpetuate the original location of this corner:

Set a 2½ inch brass cap on a 1 inch iron pipe 31 ins. long and projecting 3 ins. out of the ground with a surrounding rock mound.

Brass cap marked thus: T 6 S R 44 E

$\frac{1}{4}$ $\frac{S 29}{S 32}$


CS 1979

New bearing trees:

- A fir 20 ins diam bears S 21° W, 74.2 ft dist marked 1/4 S 32 BT
- A pine 8 ins diam bears N 76° E, 44.7 ft dist marked 1/4 S 29 BT

Each new bearing tree has a sign 54-3 and a sign 54-4 attached and has a brass washer marked PLS 1639 nailed flush with BT blaze. Painted a band of silver paint around each bearing tree.

I hereby certify that the above corner monument was properly re-established on Nov. 14, 1979, under my supervision and witnessed by Bill Hanley and Tom Fisk.

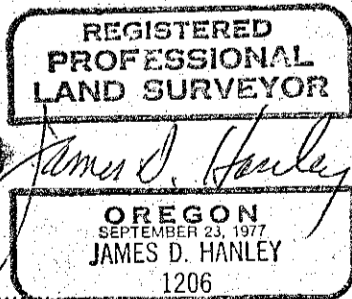

Office of..... County of.....
 State of....., I hereby certify that the within instrument was filed in this office
 for record on the..... day of....., 19.....
 by
 (COUNTY OFFICIAL) (DEPUTY)