


Index File No. Z-5 CORNER RECORD (SEARCH) Tract or Survey No. _____ Cor. 56. Lot
56. 31
 T. 6 & 7 S. R. 10 E. R.D. ~~Wallowa~~ PINE County Baker
 Merid. Willamette N.F. Wallowa-Whitman State Oregon

CORNER DIAGRAM

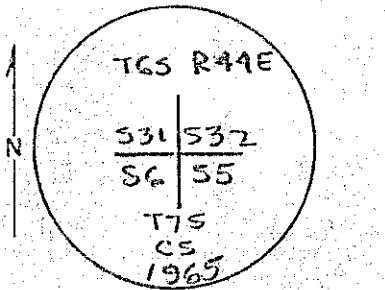

DESCRIBE CORNER MONUMENT FOUND

Original wood post not found.

DESCRIBE BEARING TREES OR OTHER OFFICIAL ACCESSORIES FOUND

Fine B.T. for sec. 32 alive.
 Fine B.T. for sec. 5 is stump.
 Fine B.T. for sec 31 alive, now 36"

PHOTO IDENTIFICATION DATA

Photo No. _____
 Filed At. _____
 Object Ident. _____
 Ident. By _____
 Signature _____

DESCRIBE CORNER LOCATION RELATIVE TO NEAR-BY FEATURES, ALSO HOW TO REACH CORNER

West of East Fork Road, F. S. cruiser tag along road.

PLANE COORDINATE POSITION DATA

State _____ Zone _____
 X _____
 Y _____
 Estab. By _____
 Agency _____

Signature _____ Title _____ Division _____ Headquarters _____ Date _____ 7100-52
 REV. 65 5

CORNER RECORD (PERPETUATION)

MONUMENT; DESCRIBE NEW MONUMENT SET, OR WORK DONE TO PRESERVE EXISTING MONUMENT

Set 1-inch galvanized pipe with 2-inch aluminum cap marked as shown.

ACCESSORIES DESCRIBE NEW BT'S WITNESS OBJECTS ETC. ESTABLISHED, OR WORK DONE TO PRESERVE EXISTING EVIDENCE


None

Work Done By J. D. Hanley Title Engineer Date 8-65 State Registration No. Oregon P.E. 2808
 or Agency _____

Certified Cor. Record Prepared? Yes No Filed At _____ Date _____

REMARKS

SURVEY NO. 6-44-1

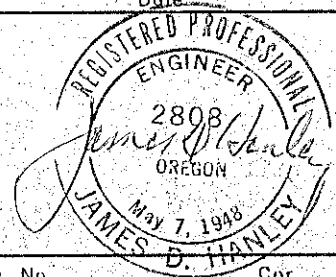

Index File No. _____ T. _____ R. _____ M. _____ Tract or Surv. No. _____ Cor. _____