

CERTIFIED RECORD OF LAND CORNER MONUMENTATION

G-13

History of original corner establishment:


Corner established by W.B. Barr under GLO contract No. 503 dated May 23, 1884.

Surveyor General records state:

Set granite rock 12 x 12 x 6, 8 ins in the ground for 1/4 sec cor marked 1/4 on the W side from which

A tamarack 30 ins dia bears N15°W 48 lks dist marked 1/4 S BT.

A fir 8 ins dia bears N45°E 53 lks dist marked 1/4 S BT.

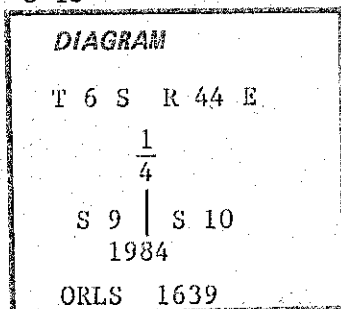

Description of corner evidence found:

Found marked stone of record dimensions.

A tamarack snag 43 ins dia bears N15°W 48 lks dist with visible scribes.

A fir 35 ins dia bears N45°E 53 lks dist with visible scribes.

Description of monument and accessories established to perpetuate the original location of this corner:

Set a 2 1/2" aluminum cap on 2" aluminum pipe 30" long 25" in ground with 5" proj. out of ground with surrounding rock mound and 6' steel fence post alongside with sign 54-9 attached. Buried found stone alongside.

Aluminum cap marked as shown in corner diagram.

New bearing tree set:

A tamarack 12 ins dia bears N64°W 56.6 ft dist marked 1/4 S9 BT.

Each original bearing tree and each new bearing tree has signs 54-3 and 54-9 attached below a 6 in band of red paint, additionally each new bearing tree has a brass washer marked PLS 1639 nailed flush with BT blaze.

I hereby certify that the above described corner monument was properly established by me and witnessed by Jim DeMastus and Daryl Schuchardt on Aug. 13, 1984.

Witnessed: Jim DeMastus



Office of...County Surveyor..... County of...Baker.....
 State of...Oregon....., I hereby certify that the within instrument was filed in this office
 for record on the..... day of....., 19.....
 by
 (COUNTY OFFICIAL) (DEPUTY)

FILED 4/28/86
 BAKER COUNTY SURVEYOR
 SURVEY NO. 6-44-14