

CERTIFIED RECORD OF LAND CORNER MONUMENTATION

L-13

History of original corner establishment:


Corner established by W.B. Barr under GLO contract No. 503 dated May 23, 1884.

Surveyor General records state:

Set granite rock 12 x 9 x 7, 8 ins in ground for 1/4 sec cor marked 1/4 on the W side from which

A pine 30 ins dia bears N60°E 15 lks dist marked 1/4 S BT.

A pine 20 ins dia bears N75°W 75 lks dist marked 1/4 S BT.

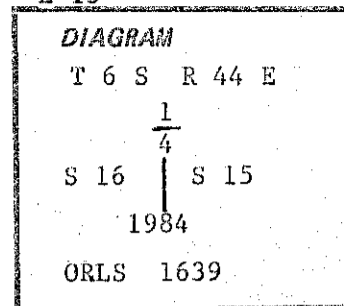

Description of corner evidence found:

Found marked stone of record dimensions.

A live pine 37 ins dia bears N60°E 15 lks dist with healed blaze.

A live pine 35 ins dia bears N75°W 75 lks dist with open blaze, scribes visible.

Description of monument and accessories established to perpetuate the original location of this corner:

Set a 2 1/2" aluminum cap on 2" aluminum pipe 30" long 25" in ground with 5" proj. out of ground with surrounding rock mound and 6' steel fence post alongside with sign 54-9 attached. Buried found stone alongside.

Aluminum cap marked as shown in corner diagram.

Each original bearing tree has signs 54-3 and 54-9 attached below a 6 inch band of red paint, and a brass washer marked PLS 1639 nailed flush with BT blaze.

I hereby certify that the above described corner monument was properly established by me and witnessed by Jim DeMastus and Daryl Schuchardt on Aug. 13, 1984.

Witnessed: Jim DeMastus

REGISTERED PROFESSIONAL LAND SURVEYOR

William L Hanley

OREGON JULY 14, 1978 WILLIAM L. HANLEY 1639

Office of.....County Surveyor..... County of.....Baker.....
State of.....Oregon....., I hereby certify that the within instrument was filed in this office
for record on the..... day of....., 19.....

..... by
(COUNTY OFFICIAL) (DEPUTY)

FILED 4/28/86
BAKER COUNTY SURVEYOR
SURVEY NO. 6-44-15