


CERTIFIED RECORD OF LAND CORNER MONUMENTATION

N-5

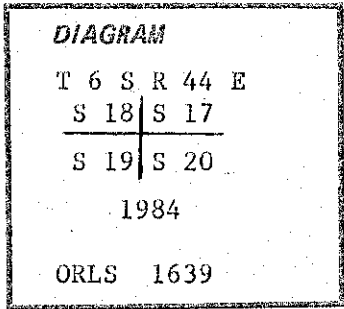

History of original corner establishment:

Corner established by W.B. Barr under GLO contract No. 503 dated May 23, 1884.

Surveyor General records state:

Set slate stone 18 x 10 x 8, 12 ins in ground for cor to secs 17, 18, 19 & 20 marked with 3 notches on the S & 5 notches on the E edges from which

A fir 55 ins dia bears N55°E, 238 lks dist marked T6SR44ES17 BT.
 A fir 15 ins dia bears S05°E, 32 lks dist marked T6SR44ES20 BT.
 No other trees within limits.

Description of corner evidence found:

No trace of marked stone.

A down fir 24 ins dia with healed blaze at 32 lks dist, bears S05°E.

A live fir 62 ins dia with healed blaze at 238 lks dist, bears N55°E.

Description of monument and accessories established to perpetuate the original location of this corner:

Set a 2½" aluminum cap on 2" aluminum pipe 30" long 25" in ground with 5" proj. out of ground with surrounding rock mound and 6' steel fence post alongside with sign 54-9 attached.

Aluminum cap marked as shown in corner diagram.

New bearing trees established:

A fir 20 ins dia bears N44°W, 293.4 ft dist marked T6SR44ES18 BT.
 A fir 14 ins dia bears S56°W, 15.2 ft dist marked T6SR44ES19 BT.
 A fir 8 ins dia bears S79°E, 154.2 ft dist marked T6SR44ES20 BT.

Each original bearing tree and each new bearing tree has signs 54-3 and 54-9 attached below a 6 in band of red paint, additionally each new bearing tree has a brass washer marked PLS 1639 nailed flush with BT blaze.

I hereby certify that the above described corner monument was properly established by me and witnessed by Jim DeMastus and Daryl Schuchardt on Sept. 24, 1984.

Witnessed: Jim DeMastus

**REGISTERED
PROFESSIONAL
LAND SURVEYOR**

William L. Hanley

**OREGON
JULY 14, 1978
WILLIAM L. HANLEY
1639**

Office of County Surveyor..... County of Baker.....
 State of Oregon....., I hereby certify that the within instrument was filed in this office
 for record on the..... day of....., 19.....

..... by
 (COUNTY OFFICIAL) (DEPUTY)

FILED 4-28-86
 BAKER COUNTY SURVEYOR
 SURVEY NO. 6-44-17