

CERTIFIED RECORD OF LAND CORNER MONUMENTATION

N-7

History of original corner establishment:


Corner established by W.B. Barr under GLO contract No. 503 dated May 23, 1884.

Surveyor General records state:

Set granite rock 12 x 10 x 8, 8 ins in ground for 1/4 sec cor marked 1/4 on the N side from which

A fir 20 ins dia bears S20°W, 20 lks dist marked 1/4S BT.

A fir 14 ins dia bears N45°E, 52 lks dist marked 1/4S BT.

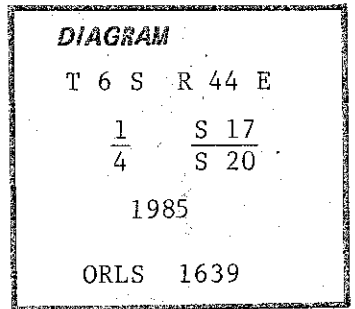

Description of corner evidence found:

Found no trace of marked stone.

NONE: Corner position established by survey methods described on accompanying official RECORD OF SURVEY PLAT for dependent resurvey of a portion of T 6 S, R 44 E, W. M.

Description of monument and accessories established to perpetuate the original location of this corner:

Set 2 1/2" aluminum cap on 2" aluminum pipe 30" long 25" in ground with 5" proj out of ground with surrounding rock mound and 6' steel fence post alongside with sign 54-9 attached.

Aluminum cap marked as shown in corner diagram.

New bearing trees established:

A fir 8 ins dia bears S51°W, 18.3 ft dist marked 1/4S20 BT.

A fir 14 ins dia bears N21°W, 13.2 ft dist marked 1/4S17 BT.

Each original bearing tree and each new bearing tree has signs 54-3 and 54-9 attached below a 6 in band of red paint, additionally each new bearing tree has a brass washer marked PLS 1639 nailed flush with BT blaze.

I hereby certify that the above described corner monument was properly established by me and witnessed by Jim DeMastus and Daryl Schuchardt on Aug. 14, 1985.

Witnessed: Jim DeMastus

**REGISTERED  
PROFESSIONAL  
LAND SURVEYOR**

*William L. Hanley*

**OREGON  
JULY 14, 1978  
WILLIAM L. HANLEY  
1639**

Office of County Surveyor..... County of Baker  
State of Oregon....., I hereby certify that the within instrument was filed in this office

for record on the..... day of....., 19.....

..... by .....

(COUNTY OFFICIAL)

(DEPUTY)

FILED 4-28-80  
BAKER COUNTY SURVEYOR  
SURVEY NO. 6-44-18