


CERTIFIED RECORD OF LAND CORNER MONUMENTATION

N- 9

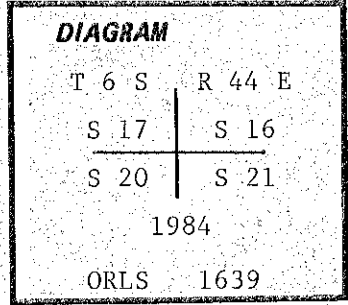

**History of original corner establishment:**

Corner established by W.B. Barr under GLO contract No. 503 dated May 23, 1884.

Surveyor General records state:

Set granite rock 12 x 8 x 6, 8 ins in ground for cor to secs 16, 17, 20 & 21 marked with 3 notches on the S and 4 notches on the E edges from which

- A fir 6 ins dia bears N82°E, 125 lks dist marked T6SR44ES16 BT.
- A pine 10 ins dia bears N32°W, 50 lks dist marked T6SR44ES17 BT.
- A fir 5 ins dia bears S80°W, 76 lks dist marked T6SR44ES20 BT.
- A pine 8 ins dia bears S32½°E, 139 lks dist marked T6SR44ES21 BT.

**Description of corner evidence found:**

Found marked stone of record dimensions.

- A pine windblow snag bears N32°W, 50 lks dist with full record scribes.
- A fir snag 22 ins dia bears N82°E, 115 lks (record states 125 lks) dist with healed blaze.

**Description of monument and accessories I established to perpetuate the original location of this corner:**

Set 2½" aluminum cap on 2" aluminum pipe 30" long 25" in ground with 5" proj out of ground with surrounding rock mound and 6' steel fence post alongside with sign 54-9 attached. Buried marked stone monument alongside.

Aluminum cap marked as shown in corner diagram.

New bearing trees established:

- A fir 13 ins dia bears N44°E, 12.0 ft dist marked T6SR44ES16 BT.
- A fir 17 ins dia bears S25°E, 32.2 ft dist marked T6SR44ES21 BT.
- A fir 18 ins dia bears S29°W, 29.4 ft dist marked T6SR44ES20 BT.
- A fir 16 ins dia bears N30°W, 9.2 ft dist marked T6SR44ES17 BT.

Each original bearing tree and each new bearing tree has signs 54-3 and 54-9 attached below a 6 in band of red paint, additionally each new bearing tree has a brass washer marked PLS 1639 nailed flush with BT blaze.

I hereby certify that the above described corner monument was properly established by me and witnessed by Jim DeMastus and Daryl Schuchardt on Aug. 15, 1984.

Witnessed: Jim DeMastus



Office of..... County Surveyor..... County of..... Baker.....  
 Oregon  
 State of....., I hereby certify that the within instrument was filed in this office  
 for record on the..... day of..... 19.....  
 by.....  
 (COUNTY OFFICIAL) (DEPUTY)

FILED 4-28-86  
 BAKER COUNTY SURVEYOR  
 SURVEY NO. 6-44-19