


CERTIFIED RECORD OF LAND CORNER MONUMENTATION

History of original corner establishment:
None, corner established this survey.

N-10

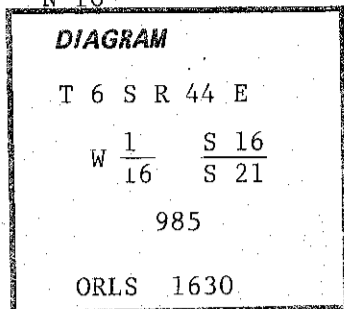

Description of corner evidence found:

None.

Description of monument and accessories I established to perpetuate the original location of this corner:

Set a 2½" aluminum cap on 2" aluminum pipe 31" long buried 27" in ground with 4" proj. from ground with surrounding rock mound and 6' steel fence post alongside with sign 54-9 attached.

Aluminum cap marked as shown in corner diagram.

New bearing trees established:

A fir 9 ins dia bears S88½°W, 27.0 ft dist marked W1/16S21 BT.

A fir 8 ins dia bears NORTH, 23.2 ft dist marked W1/16S16 BT.

Each new bearing tree has a brass washer marked PLS 1639 nailed flush with BT blaze and has signs 54-3 and 54-9 attached below a 6 inch band of red paint.

I hereby certify that the above corner monument was properly established to U.S.F.S. standards under my supervision and witnessed by Jim DeMastus and Daryl Schuchardt on July 19, 1985.

**REGISTERED
PROFESSIONAL
LAND SURVEYOR**

William L. Hanley

**OREGON
JULY 14, 1978
WILLIAM L. HANLEY
1639**

Office of.....County..Surveyor..... County of.....Baker.....
State of.....Oregon....., I hereby certify that the within instrument was filed in this office
for record on the..... day of....., 19.....

..... by
(COUNTY OFFICIAL) (DEPUTY)

FILED 4-28-86

BAKER COUNTY SURVEYOR
SURVEY NO. 6-44-20