


CERTIFIED RECORD OF LAND CORNER MONUMENTATION

N-11

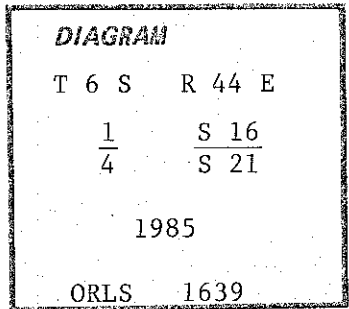

**History of original corner establishment:**

Corner established by W.B. Barr under GLO contract No. 503 dated May 23, 1884.

**Surveyor General records state:**

Set granite rock 12 x 12 x 10, 8 ins in ground for 1/4 sec cor marked 1/4 on the N side from which

A balsam 15 ins dia bears  $s67^{\circ}E$ , 55 lks dist marked 1/4S BT.

A balsam 13 ins dia bears  $N78^{\circ}W$ , 101 lks dist marked 1/4S BT.

**Description of corner evidence found:**

NOTE: Corner position established by survey methods described on accompanying official RECORD OF SURVEY PLAT for dependent resurvey of a portion of T 6 S, R 44 E, W. M.

**Description of monument and accessories established to perpetuate the original location of this corner:**

Set a 2 1/2" aluminum cap on 2" aluminum pipe 30" long 25" in ground with 5" proj. out of ground with surrounding rock mound and 6' steel fence post alongside with sign 54-9 attached, and 180 lbs concrete encasement.

Aluminum cap marked as shown in corner diagram.

**New bearing trees established:**

A cottonwood 28 ins dia bears  $N31^{\circ}E$ , 304.8 ft dist marked 1/4S16 BT.

A spruce 25 ins dia bears  $S03 1/2^{\circ}W$ , 176.2 ft dist marked 1/4S21 BT.

Each new bearing tree has signs 54-3 and 54-9 attached below a 6 inch band of red paint, and a brass washer marked PLS 1639 nailed flush with BT blaze.

I hereby certify that the above described corner monument was properly established by me and witnessed by Jim DeMastus and Daryl Schuchardt on Aug. 29, 1985.

Witnessed: Jim DeMastus



Office of... County Surveyor..... County of... Baker  
Oregon  
State of....., I hereby certify that the within instrument was filed in this office  
for record on the..... day of....., 19....

..... by .....  
(COUNTY OFFICIAL) (DEPUTY)

FILED 4-28-86  
BAKER COUNTY SURVEYOR  
SURVEY NO. 6-44-21