


CERTIFIED RECORD OF LAND CORNER MONUMENTATION

N-13

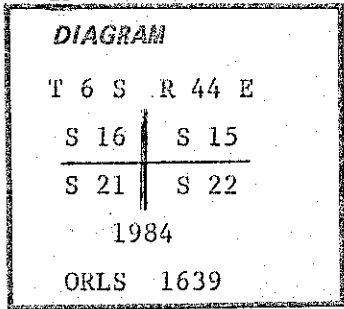

History of original corner establishment:

Corner established by W.B. Barr under GLO contract No. 503 dated May 23, 1884.

Surveyor General records state:

Set basalt rock 16 x 16 x 3, 11 ins in the ground for cor to sec's 15, 16, 21, 22 marked with 3 notches on the S & E edges from which

A pine 10 ins dia bears S43°W, 49 lks dist marked T6SR44ES21 BT. No other trees within limits.

Description of corner evidence found:

Found stone 16 x 16 x 3, at record position from original BT, no chisle work identified.

A pine 31 ins dia at 49 lks dist with scribing visible on a partially healed blaze, bears S43°W.

New bear

Description of monument and accessories established to perpetuate the original location of this corner:

Set a 2 1/2" aluminum cap on 2" aluminum pipe 30" long 25" in ground with 5" proj. out of ground with surrounding rock mound and 6' steel fence post alongside with sign 54-9 attached. Buried found stone alongside.

Aluminum cap marked as shown in corner diagram.

New bearing trees established:

A fir 10 ins dia bears N61°E, 134.6 ft dist marked T6SR44ES15 BT.

A fir 9 ins dia bears S01°E, 52.5 ft dist marked T6SR44ES22 BT.

A fir 19 ins dia bears N01°W, 56.7 ft dist marked T6SR44ES16 BT.

Each original bearing tree and each new bearing tree has signs 54-3 and 54-9 attached below a 6 in band of red paint, additionally each new bearing tree has a brass washer marked PLS 1639 nailed flush with BT blaze.

I hereby certify that the above described corner monument was properly established by me and witnessed by Jim DeMastus and Daryl Schuchardt on April 9, 1984.

Witnessed: Jim DeMastus



Office of...County Surveyor..... County of...Baker.....
 State of...Oregon....., I hereby certify that the within instrument was filed in this office
 for record on the..... day of....., 19.....

..... by
 (COUNTY OFFICIAL) (DEPUTY)