

CERTIFIED RECORD OF LAND CORNER MONUMENTATION

P-5

History of original corner establishment:


Corner established by W.B. Barr under GLO contract No. 503 dated May 23, 1884.

Surveyor General records state:

Set basalt rock 16 x 12 x 5, 11 ins in ground for 1/4 sec cor marked 1/4 on the W side from which

A fir 5 ins dia bears N80°W, 99 lks dist marked 1/4 S BT.

A fir 5 ins dia bears S88°E, 61 lks dist marked 1/4 S BT.

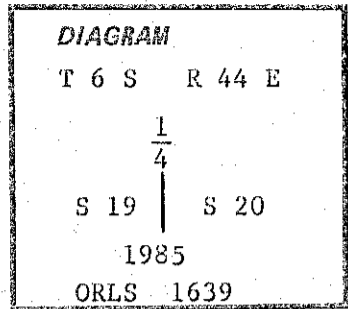

Description of corner evidence found:

NOTE: Corner position established by survey methods described on accompanying official RECORD OF SURVEY PLAT for dependent resurvey of a portion of T 6 S, R 44 E, W. M.

Description of monument and accessories established to perpetuate the original location of this corner:

Set a 2 1/2" aluminum cap on 2" aluminum pipe 30" long 25" in ground with 5" proj. out of ground with surrounding rock mound and 6' steel fence post alongside with sign 54-9 attached.

Aluminum cap marked as shown in corner diagram.

New bearing trees established:

A fir 20 ins dia bears S69°W, 270.7 ft dist marked 1/4 S19 BT.

A fir 18 ins dia bears S18 1/2°E, 321.3 ft dist marked 1/4 S20 BT.

Each new bearing tree has signs 54-3 and 54-9 attached below a 6 inch band of red paint, and a brass washer marked PLS 1639 nailed flush with BT blaze.

I hereby certify that the above described corner monument was properly established by me and witnessed by Jim DeMastus and Daryl Schuchardt on Aug. 22, 1985.

Witnessed: Jim DeMastus



Office of...County Surveyor..... County of...Baker.....
State of...Oregon....., I hereby certify that the within instrument was filed in this office
for record on the..... day of....., 19.....

(COUNTY OFFICIAL)

(DEPUTY)

FILED 4-28-86
BAKER COUNTY SURVEYOR
SURVEY NO. 6-44-23