

CERTIFIED RECORD OF LAND CORNER MONUMENTATION

P-9

History of original corner establishment:


Corner established by W.B. Barr under GLO contract No. 503 dated May 23, 1884.

Surveyor General records state:

A basalt rock in place 36 x 10 x 6 above ground for 1/4 sec cor marked with a cross (+) on top. 1/4 on the W side from which

A fir 15 ins dia bears N60°E, 150 lks dist marked 1/4S BT.

No other trees within limits.

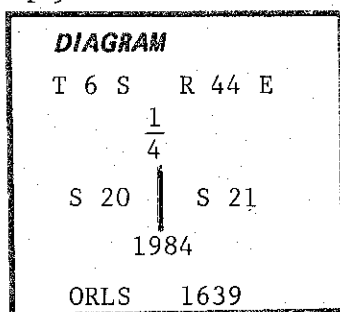

Description of corner evidence found:

Found marked stone of record dimensions.

A douglas fir 32 ins dia bears N60°E, 150 lks dist with double healed blaze.

Description of monument and accessories | established to perpetuate the original location of this corner:

Set 2 1/2" aluminum cap on 2" aluminum pipe 30" long 25" in ground with 5" proj out of ground with surrounding rock mound and 6' steel fence post alongside with sign 54-9 attached. Buried marked stone monument alongside.

Aluminum cap marked as shown in corner diagram.

New bearing tree established:

A fir 22 ins dia bears S63°W, 24.8 ft dist marked 1/4S20 BT.

Each original bearing tree and each new bearing tree has signs 54-3 and 54-9 attached below a 6 in band of red paint, additionally each new bearing tree has a brass washer marked PLS 1639 nailed flush with BT blaze.

I hereby certify that the above described corner monument was properly established by me and witnessed by Jim DeMastus and Daryl Schuchardt on Aug. 13, 1984.

Witnessed: Jim DeMastus



Office of... County Surveyor..... County of... Baker
 State of... Oregon....., I hereby certify that the within instrument was filed in this office
 for record on the..... day of....., 19.....
 by
 (COUNTY OFFICIAL) (DEPUTY)