

CERTIFIED RECORD OF LAND CORNER MONUMENTATION

P-13

**History of original corner establishment:**


Corner established by W.B. Barr under GLO contract No. 503 dated May 23, 1884.

**Surveyor General records state:**

Set post 4 ft long 4 ins dia 24 ins in ground for 1/4 sec corner marked 1/4S on the W side from which

A fir 8 ins dia bears N78°W, 49 lks dist marked 1/4S BT.

A tamarack 10 ins dia bears S49°E, 60 lks dist marked 1/4S BT.

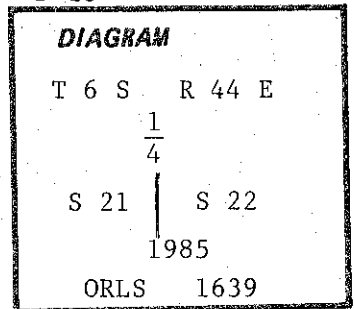

**Description of corner evidence found:**

NOTE: Corner position established by survey methods described on accompanying official RECORD OF SURVEY PLAT for dependent resurvey of a portion of T 6 S, R 44 E, W. M.

**Description of monument and accessories established to perpetuate the original location of this corner:**

Set 2 1/2" aluminum cap on 2" aluminum pipe 30" long 25" in ground with 5" proj out of ground with surrounding rock mound and 6' steel fence post alongside with sign 54-9 attached.

Aluminum cap marked as shown in corner diagram.

**New bearing trees established:**

A fir 10 ins dia bears N53°E, 23.4 ft dist marked 1/4S22 BT.

A fir 14 ins dia bears S23°W, 49.6 ft dist marked 1/4S21 BT.

Each new bearing tree has signs 54-3 and 54-9 attached below a 6 inch band of red paint, and a brass washer marked PLS 1639 nailed flush with BT blaze.

I hereby certify that the above described corner monument was properly established by me and witnessed by Jim DeMastus and Daryl Schuchardt on July 22, 1985.

Witnessed: Jim DeMastus

**REGISTERED  
PROFESSIONAL  
LAND SURVEYOR**

*William L. Hanley*

**OREGON  
JULY 14, 1978  
WILLIAM L. HANLEY  
1639**

Office of County Surveyor ..... County of Baker .....  
State of Oregon ..... I hereby certify that the within instrument was filed in this office  
for record on the ..... day of ..... , 19.....

..... by .....  
(COUNTY OFFICIAL) (DEPUTY)