

CERTIFIED RECORD OF LAND CORNER MONUMENTATION

R-1


History of original corner establishment:

Corner established by W.B. Barr under GLO contract No. 503 dated May 23, 1884.

Surveyor General records state:

Set basalt rock 12 x 12 x 5, 8 inches in ground for cor to secs 19, 24, 24 & 30 marked with 4 notches on the N and 2 notches on the S edges from which

- A fir 40 ins dia bears N63°E, 63 lks dist marked T6SR44ES19 BT.
- A fir 20 ins dia bears N41½°W, 83 lks dist marked T6SR43ES24 BT.
- A fir 6 ins dia bears S73°W, 239 lks dist marked T6SR43ES25 BT.
- A fir 7 ins dia bears S78°E, 64 lks dist marked T6SR44ES30 BT.

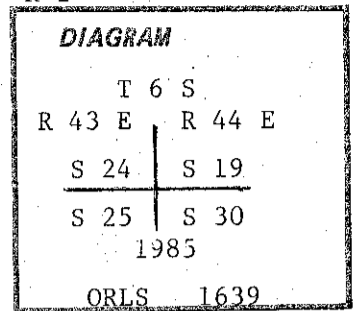

Description of corner evidence found:

Found no trace of marked stone.

- A fir 60 ins dia bears N33°E (record states N63°E) 42.9 ft dist with fully healed blaze.
- A dead log bears N41½°W, 54.8 ft dist with full scribes visible.
- A fir 16 ins dia bears S78°E, 157.8 ft dist with fully healed blaze.
- No trace of other bearing tree.

Description of monument and accessories established to perpetuate the original location of this corner:

Set 2½" aluminum cap on 2" aluminum pipe 30" long 25" in ground with 5" proj out of ground with surrounding rock mound and 6' steel fence post alongside with sign 54-9 attached.

Aluminum cap marked as shown in corner diagram.

New bearing trees:

- A fir 11 ins dia bears N36½°W, 31.5 ft dist marked T6SR43ES24 BT.
- A fir 13 ins dia bears S74°W, 77.8 ft dist marked T6SR43ES25 BT.

Each original bearing tree and each new bearing tree has signs 54-3 and 54-9 attached below a 6 in band of red paint, additionally each new bearing tree has a brass washer marked PLS 1639 nailed flush with BT blaze.

I hereby certify that the above described corner monument was properly established by me and witnessed by Jim DeMastus and Daryl Schuchardt on Aug. 14, 1985.

Witnessed: Jim DeMastus



Office of County Surveyor..... County of Baker
 State of Oregon..... I hereby certify that the within instrument was filed in this office
 for record on the..... day of....., 19.....
 by
 (COUNTY OFFICIAL) (DEPUTY)

FILED 4-28-86
 BAKER COUNTY SURVEYOR
 SURVEY NO. 6-44-28