


CERTIFIED RECORD OF LAND CORNER MONUMENTATION

R-3

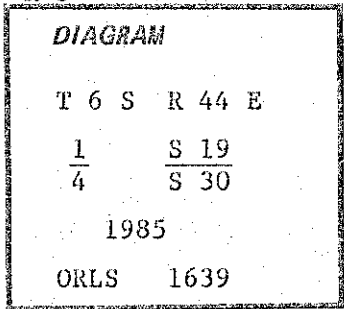

History of original corner establishment:

Corner established by W.B. Barr under GLO contract No. 503 dated May 23, 1884.

Surveyor General records state:

Set sandstone 16 x 15 x 10, 11 ins in ground for $\frac{1}{4}$ sec cor marked $\frac{1}{4}$ on the W side from which:

A spruce 6 ins dia bears S10°W, 159 lks dist marked 1/4S BT.

A spruce 30 ins dia bears N78°E, 200 lks dist marked 1/4S BT.

Description of corner evidence found:

NOTE: Corner position established by survey methods described on accompanying official RECORD OF SURVEY PLAT for dependent resurvey of a portion of T 6 S, R 44 E, W. M.

Description of monument and accessories established to perpetuate the original location of this corner:

Set a 2 $\frac{1}{2}$ " aluminum cap on 2" aluminum pipe 30" long 25" in ground with 5" proj. out of ground with surrounding rock mound and 6' steel fence post alongside with sign 54-9 attached.

Aluminum cap marked as shown in corner diagram.

New bearing trees established:

A fir 8 ins dia bears N34°E, 14.1 ft dist marked 1/4S19 BT.

A fir 12 ins dia bears S27 $\frac{1}{2}$ °E, 23.5 ft dist marked 1/4S30 BT.

Each new bearing tree has signs 54-3 and 54-9 attached below a 6 inch band of red paint, and a brass washer marked PLS 1639 nailed flush with BT blaze.

I hereby certify that the above described corner monument was properly established by me and witnessed by Jim DeMastus and Daryl Schuchardt on Aug. 22, 1985.

Witnessed: Jim DeMastus

**REGISTERED
PROFESSIONAL
LAND SURVEYOR**

William L. Hanley

**OREGON
JULY 14, 1978
WILLIAM L. HANLEY
1639**

Office of.....County Surveyor..... County of..... Baker.....
State of..... Oregon..... I hereby certify that the within instrument was filed in this office
for record on the..... day of....., 19.....

..... by
(COUNTY OFFICIAL) (DEPUTY)

FILED 4-28-86
BAKER COUNTY SURVEYOR
SURVEY NO. 6-44-29