

CERTIFIED RECORD OF LAND CORNER MONUMENTATION


History of original corner establishment:

Corner established by W.B. Barr under GLO contract No. 503 dated May 23, 1884.

Surveyor General records state:

Set state stone 12 x 10 x 6, 8 ins in ground for cor to secs 20, 21, 28 & 29 marked with 2 notches on the S and 4 notches on the E edges from which

- A fir 10 ins dia bears N63°E, 9 lks dist marked T6SR44ES21 BT.
- A fir 6 ins dia bears N35°W, 18 lks dist marked T6SR44ES20 BT.
- A fir 6 ins dia bears S28°W, 5 lks dist marked T6SR44ES29 BT.
- A fir 7 ins dia bears S70°E, 7 lks dist marked T6SR44ES28 BT.

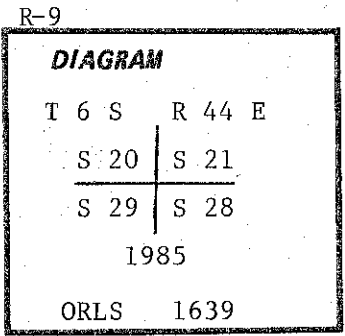

Description of corner evidence found:

No trace of marked stone.

- A fir 8 ins dia bears S82°E (record states S70°E) 7 lks dist with full scribes on previously opened blaze.
- A fir stump with log downhill bears S28°W, 5 lks dist with visible scribes.
- A fir 13 ins dia bears N57°W (record states N35°W) 18 lks dist with healed blaze (by increment bore found pitch mark at 100 years by ring count)

Description of monument and accessories | established to perpetuate the original location of this corner:

Set 2½" aluminum cap on 2" aluminum pipe 30" long 25" in ground with 5" proj out of ground with surrounding rock mound and 6' steel fence post alongside with sign 54-9 attached.

Aluminum cap marked as shown in corner diagram.

New bearing trees established:

- A fir 13 ins dia bears N73°E, 27.6 ft dist marked T6SR44ES21 BT.
- A fir 10 ins dia bears S06°E, 11.0 ft dist marked T6SR44ES28 BT.
- A fir 8 ins dia bears S09°W, 22.5 ft dist marked T6SR44ES29 BT.

Each original bearing tree and each new bearing tree has signs 54-3 and 54-9 attached below a 6 in band of red paint, additionally each new bearing tree has a brass washer marked PLS 1639 nailed flush with BT blaze.

I hereby certify that the above described corner monument was properly established by me and witnessed by Jim DeMastus and Daryl Schuchardt on July 2, 1985.

Witnessed: Jim DeMastus

**REGISTERED
PROFESSIONAL
LAND SURVEYOR**

William L. Hanley

OREGON
JULY 14, 1978
WILLIAM L. HANLEY
1639

Office of... County Surveyor..... County of... Baker
 State of... Oregon..... I hereby certify that the within instrument was filed in this office
 for record on the..... day of....., 19.....
 by
 (COUNTY OFFICIAL) (DEPUTY)

FILED 4-28-86
 BAKER COUNTY SURVEYOR
 SURVEY NO. 6-44-32