

CERTIFIED RECORD OF LAND CORNER MONUMENTATION

R-11

History of original corner establishment:


Corner established by W.B. Barr under GLO contract No. 503 dated May 23, 1884.

Surveyor General records state:

Set granite rock 12 x 10 x 7, 8 ins in ground for 1/4 sec cor marked 1/4 on the N side from which

A black pine 15 ins dia bears N22°E, 14 lks dist marked 1/4S BT.

A black pine 15 ins dia bears S25°E, 47 lks dist marked 1/4S BT.

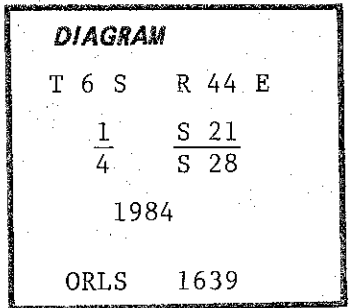

Description of corner evidence found:

Found marked stone of record dimensions.

A windblow bears N22°E, 14 lks dist with no visible scribes in rotten wood.

A root-hole bears S25°E, 47 lks dist.

Description of monument and accessories | established to perpetuate the original location of this corner:

Set 2 1/2" aluminum cap on 2" aluminum pipe 30" long 25" in ground with 5" proj out of ground with surrounding rock mound and 6' steel fence post alongside with sign 54-9 attached. Buried marked stone monument alongside.

Aluminum cap marked as shown in corner diagram.

New bearing trees established:

A fir 10 ins dia bears N34°W, 20.8 ft dist marked 1/4S21 BT.

A fir 12 ins dia bears S78°W, 18.5 ft dist marked 1/4S28 BT.

Each new bearing tree has signs 54-3 and 54-9 attached below a 6 ins band of red paint and has a brass washer marked PLS 1639 nailed flush with BT blaze.

I hereby certify that the above described corner monument was properly established by me and witnessed by Jim DeMastus and Daryl Schuchardt on Sept. 25, 1984.

Witnessed: Jim DeMastus

**REGISTERED
PROFESSIONAL
LAND SURVEYOR**

William L. Hanley

**OREGON
JULY 14, 1978
WILLIAM L. HANLEY
1639**

Office of... County Surveyor..... County of... Baker
Oregon

State of....., I hereby certify that the within instrument was filed in this office for record on the..... day of....., 19.....

..... by
(COUNTY OFFICIAL) (DEPUTY)

FILED 4-28-86
BAKER COUNTY SURVEYOR
SURVEY NO. 6-44-33