

CERTIFIED RECORD OF LAND CORNER MONUMENTATION

R-13


History of original corner establishment:

Corner established by W.B. Barr under GLO contract No. 503 dated May 23, 1884.

Surveyor General records state:

Set granite rock 14 x 14 x 5, 10 ins in ground for cor to secs 21, 22, 27 & 28 marked with 2 notches on the S and 3 notches on the E edges from which

- A pine 10 ins dia bears N03°E, 18 lks dist marked T6SR44ES22 BT.
- A pine 4 ins dia bears N06°W, 19 lks dist marked T6SR44ES21 BT.
- A pine 10 ins dia bears S55°W, 28 lks dist marked T6SR44ES28 BT.
- A pine 5 ins dia bears S72°E, 51 lks dist marked T6SR44ES27 BT.

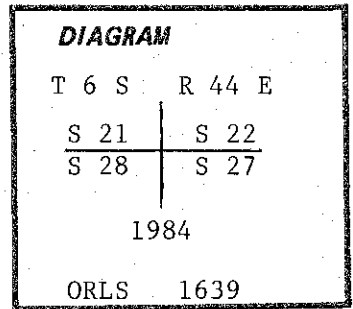

Description of corner evidence found:

No trace of marked stone.

- A pine 14 ins dia bears S55°E, 18 lks dist with 3" overgrowth and visible scribes.
- A pine 18 ins dia bears N06°W, 19 lks dist with a healed blaze.
- A piece of tree bearing N03°E, 18 lks dist with "R44" on partially healed blaze.
- No trace of sec 27 BT.

Description of monument and accessories established to perpetuate the original location of this corner:

Set 2½" aluminum cap on 2" aluminum pipe 30" long 25" in ground with 5" proj out of ground with surrounding rock mound and 6' steel fence post alongside with sign 54-9 attached.

Aluminum cap marked as shown in corner diagram.

New bearing trees established:

- A fir 10 ins dia bears S07°E, 22.3 ft dist marked T6SR44ES27 BT.
- A fir 7 ins dia bears N07°E, 29.7 ft dist marked T6SR44ES22 BT.

Each original bearing tree and each new bearing tree has signs 54-3 and 54-9 attached below a 6 in band of red paint, additionally each new bearing tree has a brass washer marked PLS 1639 nailed flush with BT blaze.

I hereby certify that the above described corner monument was properly established by me and witnessed by Jim DeMastus and Daryl Schuchardt on Sept. 25, 1984.

Witnessed: Jim DeMastus

**REGISTERED
PROFESSIONAL
LAND SURVEYOR**

William L. Hanley

**OREGON
JULY 14, 1978
WILLIAM L. HANLEY
1639**

Office of...County Surveyor..... County of...Baker.....
State of...Oregon....., I hereby certify that the within instrument was filed in this office
for record on the..... day of....., 19.....

..... by
(COUNTY OFFICIAL) (DEPUTY)

FILED 4-28-86
BAKER COUNTY SURVEYOR
SURVEY NO. 6-44-34