

CERTIFIED RECORD OF LAND CORNER MONUMENTATION


History of original corner establishment:

Corner established by W.B. Barr under GLO contract No. 503 dated May 23, 1884.

Surveyor General records state:

Set granite rock 12 x 12 x 10, 8 inches in ground for 1/4 sec cor marked 1/4 on W side from which:

A fir 20 ins dia bears N55°W, 20 lks dist marked 1/4S BT.  
A fir 24 ins dia bears N40°E, 14 lks dist marked 1/4S BT.

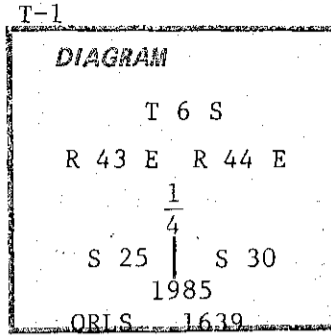

Description of corner evidence found:

NOTE: Corner position established by survey methods described on accompanying official RECORD OF SURVEY PLAT for dependent resurvey of a portion of T 6 S, R 44 E, W. M.

Description of monument and accessories established to perpetuate the original location of this corner:

Set a 2 1/2" aluminum cap on 2" aluminum pipe 30" long 25" in ground with 5" proj. out of ground with surrounding rock mound and 6' steel fence post alongside with sign 54-9 attached.

Aluminum cap marked as shown in corner diagram.

New bearing trees established:

A fir 8 ins dia bears N51°W, 16.9 ft dist marked 1/4S25BT.  
A fir 19 ins dia bears N45°E, 79.3 ft dist marked 1/4S30 BT.

Each new bearing tree has signs 54-3 and 54-9 attached below a 6 inch band of red paint, and a brass washer marked PLS 1639 nailed flush with BT blaze.

I hereby certify that the above described corner monument was properly established by me and witnessed by Jim DeMastus and Daryl Schuchardt on Aug. 30, 1985.

Witnessed: Jim DeMastus

REGISTERED  
PROFESSIONAL  
LAND SURVEYOR

William L. Hanley  
OREGON  
JULY 14, 1978  
WILLIAM L. HANLEY  
1639

Office of..County..Surveyor..... County of..Baker.....

State of...Oregon....., I hereby certify that the within instrument was filed in this office for record on the..... day of....., 19.....

..... by .....  
(COUNTY OFFICIAL) (DEPUTY)