

CERTIFIED RECORD OF LAND CORNER MONUMENTATION

History of original corner establishment:

Corner established by W.B. Barr under GLO contract No. 503 dated May 23, 1884.


Surveyor General records state:

A basalt rock in place 20 x 15 x 5, 11 ins above ground for 1/4 sec cor marked with a cross (+) on the top and 1/4 on the W side from which

A fir 4 ins dia bears S80°E, 20 lks dist marked 1/4S BT.

A fir 5 ins dia bears S03°W, 22 lks dist marked 1/4S BT.

T-5

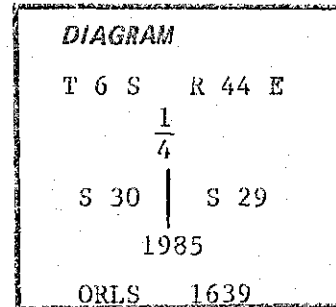

Description of corner evidence found:

NOTE: Corner position established by survey methods described on accompanying official RECORD OF SURVEY PLAT for dependent resurvey of a portion of T 6 S, R 44 E, W. M.

Description of monument and accessories established to perpetuate the original location of this corner:

Set a 2 1/2" aluminum cap on 2" aluminum pipe 30" long 25" in ground with 5" proj. out of ground with surrounding rock mound and 6' steel fence post alongside with sign 54-9 attached.

Aluminum cap marked as shown in corner diagram.

New bearing trees established:

A fir 8 ins dia bears N28°W, 25.0 ft dist marked 1/4S30 BT.

A fir 9 ins dia bears N58 1/2°E, 24.3 ft dist marked 1/4S29 BT.

Each new bearing tree has signs 54-3 and 54-9 attached below a 6 inch band of red paint, and a brass washer marked PLS 1639 nailed flush with BT blaze.

I hereby certify that the above described corner monument was properly established by me and witnessed by Jim DeMastus and Daryl Schuchardt on Aug. 23, 1985.

Witnessed: Jim DeMastus

REGISTERED PROFESSIONAL LAND SURVEYOR

William L. Hanley

OREGON JULY 14, 1978 WILLIAM L. HANLEY 1639

Office of.....County Surveyor..... County of..... Baker.....

State of..... Oregon....., I hereby certify that the within instrument was filed in this office for record on the..... day of....., 19.....

..... by (COUNTY OFFICIAL) (DEPUTY)

FILED 4-28-86

BAKER COUNTY SURVEYOR

SURVEY NO. 6-44-36