


CERTIFIED RECORD OF LAND CORNER MONUMENTATION

T-8

History of original corner establishment:

None, corner established this survey.

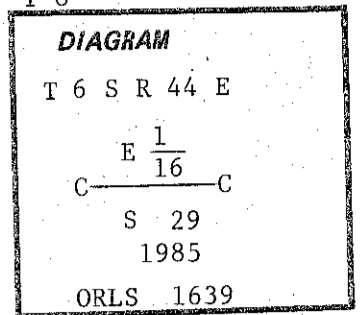

Description of corner evidence found:

None.

Description of monument and accessories established to perpetuate the original location of this corner:

Set a 2½" aluminum cap on 2" aluminum pipe 31" long buried 27" in ground with 4" proj. from ground with surrounding rock mound and 6' steel fence post alongside with sign 54-9 attached.

Aluminum cap marked as shown in corner diagram.

New bearing trees established:

A pine 18 ins dia bears N53°E, 103.6 ft dist marked CE1/16S29 BT.
A pine 12 ins dia bears N77°E, 113.2 ft dist marked CE1/16S29 BT.

Each new bearing tree has a brass washer marked PLS 1639 nailed flush with BT blaze and has signs 54-3 and 54-9 attached below a 6 inch band of red paint.

I hereby certify that the above corner monument was properly established by me to U.S.F.S. standards on Aug. 27, 1985.

**REGISTERED
PROFESSIONAL
LAND SURVEYOR**

William L Hanley

**OREGON
JULY 14, 1978
WILLIAM L. HANLEY
1639**

Office of..... County Surveyor..... County of..... Baker
State of..... Oregon....., I hereby certify that the within instrument was filed in this office
for record on the..... day of....., 19.....
..... by
(COUNTY OFFICIAL) (DEPUTY)

FILED 4-28-86
BAKER COUNTY SURVEYOR
SURVEY NO. 6-44-38