


CERTIFIED RECORD OF LAND CORNER MONUMENTATION

T-11

History of original corner establishment:

NONE-corner established this survey.

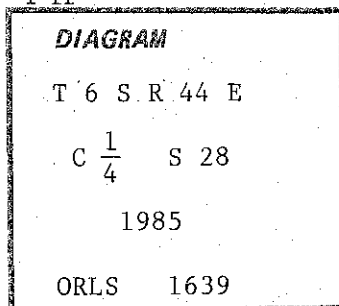

Description of corner evidence found:

None.

Description of monument and accessories established to perpetuate the original location of this corner:

Set 2½" aluminum cap on 2" aluminum pipe 30" long 25" in ground with 5" proj out of ground with surrounding rock mound and 6' steel fence post alongside with sign 54-9 attached.

Aluminum cap marked as shown in corner diagram.

New bearing trees established:


A fir 7 ins dia bears S08½°E, 18.8 ft dist mkd C1/4S28 BT.

A fir 13 ins dia bears N66°W, 31.2 ft dist mkd C1/4S28 BT.

Each new bearing tree has signs 54-3 and 54-9 attached below a 6" band of red paint and a brass washer marked PLS 1639 nailed flush with BT blaze.

I hereby certify that the above corner monument was properly maintained to U.S.F.S. standards under my supervision and witnessed by Jim DeMastus and Daryl Schuchardt on July 29, 1985.

Witnessed : Jim DeMastus

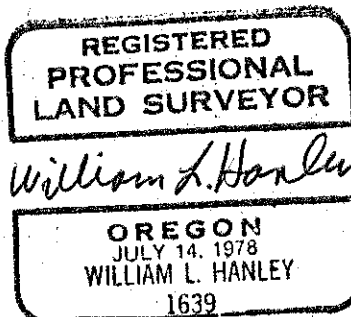

Office of County Surveyor..... County of Baker
State of Oregon....., I hereby certify that the within instrument was filed in this office
for record on the..... day of....., 19.....

..... by
(COUNTY OFFICIAL) (DEPUTY)

FILED 4-28-86
BAKER COUNTY SURVEYOR
SURVEY NO. 6-44-40