

CERTIFIED RECORD OF LAND CORNER MONUMENTATION

History of original corner establishment:

Corner established by W.B. Barr under GLO contract No. 503 dated May 23, 1884.


Surveyor General records state:

A fir 5 ins dia for 1/4 sec cor marked 1/4S on the W side from which

A tamarack 10 ins dia bears N39°W, 15 lks dist marked 1/4S BT.

A fir 4 ins dia bears S86°E, 25 lks dist marked 1/4S BT.

T-13

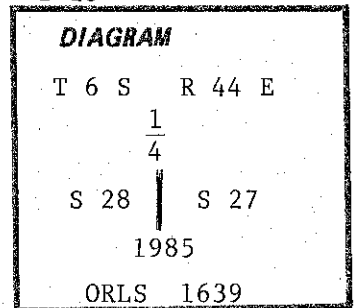

Description of corner evidence found:

NOTE: Corner position established by survey methods described on accompanying official RECORD OF SURVEY PLAT for dependent resurvey of a portion of T 6 S, R 44 E, W. M.

Description of monument and accessories established to perpetuate the original location of this corner:

Set a 2 1/2" aluminum cap on 2" aluminum pipe 30" long 16" in ground to bedrock with 14" proj. out of ground with surrounding rock mound and 6' steel fence post alongside with sign 54-9 attached.

Aluminum cap marked as shown in corner diagram.

New bearing trees established:

A fir 15 ins dia bears N58°E, 17.9 ft dist marked 1/4S27 BT.


A fir 9 ins dia bears N03 1/2°W, 43.5 ft dist marked 1/4S28 BT.

Each new bearing tree has signs 54-3 and 54-9 attached below a 6 inch band of red paint, and a brass washer marked PLS 1639 nailed flush with BT blaze.

I hereby certify that the above described corner monument was properly established by me and witnessed by Jim DeMastus and Daryl Schuchardt on July 24, 1985.

Witnessed: _____

Jim DeMastus

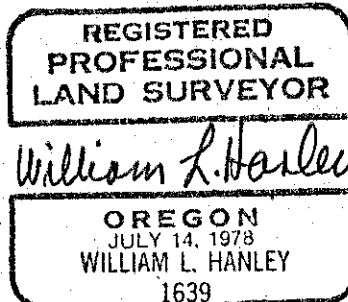

Office of...County Surveyor..... County of..Baker.....

State of...Oregon....., I hereby certify that the within instrument was filed in this office

for record on the..... day of....., 19.....

..... by

(COUNTY OFFICIAL)

(DEPUTY)

FILED 4-28-86

BAKER COUNTY SURVEYOR

KEY NO. 6-44-41