


CERTIFIED RECORD OF LAND CORNER MONUMENTATION

V-3

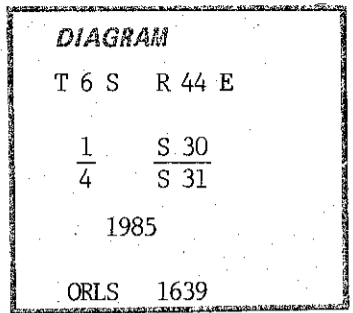

History of original corner establishment:

Corner established by W.B. Barr under GLO contract No. 503 dated May 23, 1884.

Surveyor General records state:

Set limestone 12 x 10 x 8, 8 ins in ground for $\frac{1}{4}$ sec cor marked $\frac{1}{4}$ on the N side from which

A pine 15 ins dia bears S25°E, 125 lks dist marked 1/4S BT.

No other tree within limits raised mound of rock alongside Pits impracticable.

Description of corner evidence found:

NOTE: Corner position established by survey methods described on accompanying official RECORD OF SURVEY PLAT for dependent resurvey of a portion of T 6 S, R 44 E, W. M.

Description of monument and accessories established to perpetuate the original location of this corner:

Set a 2 $\frac{1}{2}$ " aluminum cap on 2" aluminum pipe 30" long 25" in ground with 5" proj. out of ground with surrounding rock mound and 6' steel fence post alongside with sign 54-9 attached.

Aluminum cap marked as shown in corner diagram.

New bearing trees established:

A fir 17 ins dia bears S39 $\frac{1}{2}$ °W, 97.3 ft dist marked 1/4S31 BT.

A fir 7 ins dia bears N54°E, 86.5 ft dist marked 1/4S30 BT.

Each new bearing tree has signs 54-3 and 54-9 attached below a 6 inch band of red paint, and a brass washer marked PLS 1639 nailed flush with BT blaze.

I hereby certify that the above described corner monument was properly established by me and witnessed by Jim DeMastus and Daryl Schuchardt on Aug. 27, 1985.

Witnessed: Jim DeMastus

**REGISTERED
PROFESSIONAL
LAND SURVEYOR**

William L. Hanley

OREGON
JULY 14, 1978
WILLIAM L. HANLEY
1639

Office of... County Surveyor..... County of... Baker
Oregon
State of....., I hereby certify that the within instrument was filed in this office
for record on the..... day of....., 19.....

..... by
(COUNTY OFFICIAL) (DEPUTY)

FILED 4-28-86
BAKER COUNTY SURVEYOR
SURVEY NO. 6-44-42