


CERTIFIED RECORD OF LAND CORNER MONUMENTATION

V-8

History of original corner establishment:

NONE-corner established this survey.

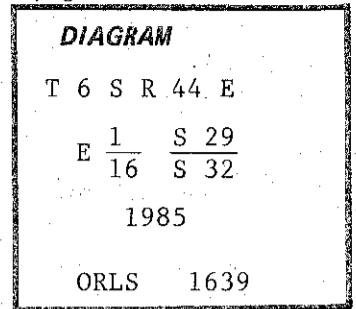

Description of corner evidence found:

None.

Description of monument and accessories established to perpetuate the original location of this corner:

Set 2½" aluminum cap on 2" aluminum pipe 6" below road surface on East edge of East Eagle Creek road, alongside road a 6' steel fence post with sign 54-9 attached.

Aluminum cap marked as shown in corner diagram.

New bearing trees established:

A pine 8 ins dia brs N04½°W, 47.6 ft dist mkd W1/16S29 BT.

A pine 8 ins dia brs S84°E, 50.1 ft dist mkd W1/16S32 BT.

Each new bearing tree has signs 54-3 and 54-9 attached below a 6" band of red paint and a brass washer marked PLS 1639 nailed flush with BT blaze.

I hereby certify that the above corner monument was properly maintained to U.S.F.S. standards under my supervision and witnessed by Jim DeMastus and Daryl Schuchardt on July 19, 1985.

Witnessed : Jim DeMastus

**REGISTERED
PROFESSIONAL
LAND SURVEYOR**

William L. Hanley

**OREGON
JULY 14, 1978
WILLIAM L. HANLEY
1639**

Office of County Surveyor County of Baker

State of Oregon, I hereby certify that the within instrument was filed in this office for record on the day of, 19.....

..... by

(COUNTY OFFICIAL)

(DEPUTY)

FILED 4-28-86
BAKER COUNTY SURVEYOR
SURVEY NO. 6-44-44