

CERTIFIED RECORD OF LAND CORNER MONUMENTATION

V-9


History of original corner establishment:

Corner established by W. B. Barr under GLO contract No. 503 dated May 23, 1884.

Surveyor's General records state:

Set post 4' long 4" square 24" in the ground for cor to secs 28, 29, 32 & 33 marked T6SS28 on the NE, R44ES33 on the SE, S32 on the SW and S29 on the NW faces with 1 notch on the S and 4 notches on the E edges from which:

- A tamarack 5 ins dia bears N87°E, 24 lks diat mkd T6SR44ES28 BT.
- A black pine 18 ins dia bears N03°W, 30 lks diat mkd T6SR44ES29 BT.
- A black pine 6 ins dia bears S31°W, 15 lks dist mkd T6SR44ES32 BT.
- A black pine 12 ins dia bears S28°E, 24 lks diat mkd T6SR44ES33 BT.

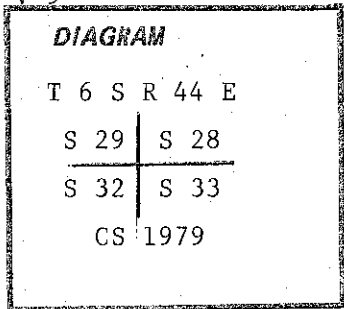

Corner REESTABLISHED by James D. Hanley on Nov. 2, 1979, and filed record of survey No. 6-44-5....Set 2½" brass cap on 1" iron pipe 31" long and projection 6" out of ground with surrounding rock-brass cap marked as shown in corner diagram.

Description of corner evidence found:

Found 2½" brass cap on 1" iron pipe in small rock mound per survey no. 6-44-5.

Description of monument and accessories I established to perpetuate the original location of this corner:

Improved surrounding rock mound around corner monument and set a 6 foot steel fence post alongside with a sign 54-9 attached.

New bearing trees established:

- A tamarack 7 ins dia bears N69°W, 32.7 ft mkd T6SR44ES29 BT.
- A fir 14 ins dia bears N06°E, 32.3 ft mkd T6SR44ES28 BT.
- A fir 9 ins dia bears S44°E, 15.2 ft mkd T6SR44ES33 BT.
- A tamarack 8 ins dia bears S10°W, 77.4 ft mkd T6SR44ES32 BT.

Each new bearing tree has signs 54-3 and 54-9 attached below a 6 inch band of red paint and has a brass washer marked PLS 1639 nailed flush with BT blaze.

I hereby certify that the above corner monument was properly maintained to U.S.F.S. standards under my supervision and witnessed by Jim DeMastus and Daryl Schuchardt on Sept. 25, 1984.

Witnessed : Jim DeMastus

**REGISTERED  
PROFESSIONAL  
LAND SURVEYOR**

*William L. Hanley*

**OREGON  
JULY 14, 1978  
WILLIAM L. HANLEY  
1639**

Office of County Surveyor..... County of Baker.....  
State of Oregon....., I hereby certify that the within instrument was filed in this office  
for record on the..... day of....., 19.....

..... by .....  
(COUNTY OFFICIAL) (DEPUTY)

FILED 4-28-86  
BAKER COUNTY SURVEYOR  
SURVEY NO. 6-44-45