


CERTIFIED RECORD OF LAND CORNER MONUMENTATION

V-13

**History of original corner establishment:**

Corner established by W.B. Barr under GLO contract No. 503 dated May 23, 1884.

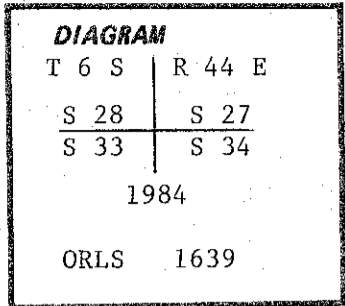

**Surveyor General records state:**

Set granite rock 10 x 10 x 8, 7 ins in ground for cor to secs 27, 28, 33 & 34 marked with 1 notch on the S & 3 notches on the E edges from which

- A pine 4 ins dia bears N22°E, 50 lks dist marked T6SR44ES27 BT.
- A pine 6 ins dia bears N62°W, 11 lks dist marked T6SR44ES28 BT.
- A pine 10 ins dia bears S49°W, 298 lks dist marked T6SR44ES33 BT.
- A pine 20 ins dia bears S43°E, 18 lks dist marked T6SR44ES34 BT.

**Description of corner evidence found:**

No trace of section 27 bearing tree or corner stone.

- A pine log rotten 12' ins dia with full scribes at 11 lks dist, bears N62°W.
- A live pine 40 ins dia with healed blaze at 18 lks dist, bears S43°E.
- A live pine 36 ins dia with healed blaze at 298 lks dist, bears S49°W.

**Description of monument and accessories | established to perpetuate the original location of this corner:**

Set 2½" aluminum cap on 2" aluminum pipe 30" long 25" in ground with 5" proj out of ground with surrounding rock mound and 6' steel fence post alongside with sign 54-9 attached.

Aluminum cap marked as shown in corner diagram.

**New bearing trees established:**

- A fir 10 ins dia bears N71°W, 30.6 ft dist marked T6SR44ES28 BT.
- A fir 15 ins dia bears N52°E, 72.6 ft dist marked T6SR44ES27 BT.

Each original bearing tree and each new bearing tree has signs 54-3 and 54-9 attached below a 6 in band of red paint, additionally each new bearing tree has a brass washer marked PLS 1639 nailed flush with BT blaze.

I hereby certify that the above described corner monument was properly established by me and witnessed by Jim DeMastus and Daryl Schuchardt on Sept. 12, 1984.

Witnessed: Jim DeMastus

**REGISTERED  
PROFESSIONAL  
LAND SURVEYOR**

*William L. Hanley*

**OREGON  
JULY 14, 1978  
WILLIAM L. HANLEY  
1639**

Office of... County Surveyor..... County of... Baker  
Oregon  
State of....., I hereby certify that the within instrument was filed in this office  
for record on the..... day of....., 19.....  
..... by .....  
(COUNTY OFFICIAL) (DEPUTY)

FILED 4-28-86  
BAKER COUNTY SURVEYOR  
SURVEY NO. 6-44-48