

CERTIFIED RECORD OF LAND CORNER MONUMENTATION


History of original corner establishment:

Corner originally established by W. L. Hanley and recorded under Baker County Survey No. 6-44-12, filed Aug. 01, 1980.

Record of Survey states:

Set 5/8" x 30" rebar.

W-8

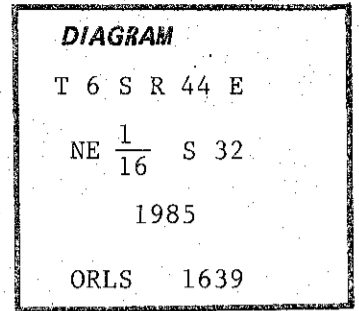

Description of corner evidence found:

Found a 5/8" x 30" rebar with a yellow plastic cap marked RPE
2808

NOTE: This found rebar bears S 31°07'48" W, 0.38 ft dist from corner position established this survey.

Description of monument and accessories established to perpetuate the original location of this corner:

Set 2½" aluminum cap on 2" aluminum pipe 30" long 25" in ground with 5" proj out of ground with surrounding rock mound and 6' steel fence post alongside with sign 54-9 attached. Buried rebar alongside aluminum monument.

Aluminum cap marked as shown in corner diagram.

New bearing trees established:

- A fir 7 ins dia brs S36°W, 27.1 ft dist mkd NE1/16S32 BT.
- A fir 11 ins dia brs S70°W, 26.7 ft dist mkd NE1/16S32 BT.

Each new bearing tree has signs 54-3 and 54-9 attached below a 6" band of red paint and a brass washer marked PLS 1639 nailed flush with BT blaze.

I hereby certify that the above corner monument was properly maintained to U.S.F.S. standards under my supervision and witnessed by Jim DeMastus and Daryl Schuchardt on July 19, 1985.

Witnessed : Jim DeMastus

**REGISTERED
PROFESSIONAL
LAND SURVEYOR**

William L. Hanley
**OREGON
JULY 14, 1978
WILLIAM L. HANLEY
1639**

Office of... County Surveyor..... County of... Baker
State of... Oregon..... I hereby certify that the within instrument was filed in this office
for record on the..... day of....., 19.....

..... by
(COUNTY OFFICIAL) (DEPUTY)

FILED 4-28-85
BAKER COUNTY SURVEYOR
SURVEY NO. 6-44-50