

CERTIFIED RECORD OF LAND CORNER MONUMENTATION


W-9

History of original corner establishment:

Corner originally established by W. L. Hanley and recorded under Baker County Survey No. 6-44-12, filed Aug. 01, 1980.

Record of Survey states:

Set 5/8" x 30" rebar.

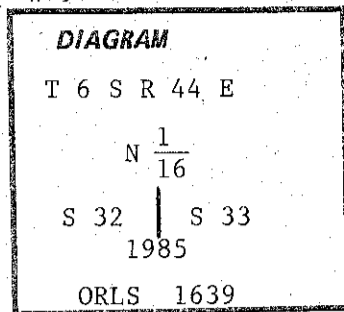

Description of corner evidence found:

Found a 5/8" x 30" rebar with a yellow plastic cap marked RPE
2808

NOTE: This found rebar bears S 36°04'08" E, 0.32 ft dist from corner position established this survey.

Description of monument and accessories established to perpetuate the original location of this corner:

Set 2 1/2" aluminum cap on 2" aluminum pipe 30" long 17" in ground with 14" proj out of ground with surrounding rock mound and 6' steel fence post alongside with sign 54-9 attached. Buried rebar alongside aluminum capped monument.

Aluminum cap marked as shown in corner diagram.

New bearing trees established:

A fir 9 ins dia brs S48 1/2° W, 54.9 ft dist mkd N1/16S32 BT.

A fir 14 ins dia brs S50 1/2° E, 42.7 ft dist mkd N1/16S33 BT.

Each new bearing tree has signs 54-3 and 54-9 attached below a 6" band of red paint and a brass washer marked PLS 1639 nailed flush with BT blaze.

I hereby certify that the above corner monument was properly maintained to U.S.F.S. standards under my supervision and witnessed by Jim DeMastus and Daryl Schuchardt on July 15, 1985.

Witnessed : Jim DeMastus

**REGISTERED
PROFESSIONAL
LAND SURVEYOR**

William L. Hanley
**OREGON
JULY 14, 1978
WILLIAM L. HANLEY
1639**

Office of... County Surveyor..... County of Baker
State of Oregon....., I hereby certify that the within instrument was filed in this office
for record on the..... day of....., 19.....
..... by
(COUNTY OFFICIAL) (DEPUTY)

FILED 4-28-86
BAKER COUNTY SURVEYOR
SURVEY NO. 6-44-51