

CERTIFIED RECORD OF LAND CORNER MONUMENTATION

X-1

History of original corner establishment:


Corner established by W.B. Barr under GLO contract No. 503 dated May 23, 1884.

Surveyor General records state:

Set basalt rock 14 x 12 x 11, 11 ins in ground marked 1/4 on the W side for 1/4 sec cor from which

A pine 5 ins dia bears N45°E, 18 lks dist marked 1/4S BT.

A pine 15 ins dia bears S35°W, 20 lks dist marked 1/4S BT.

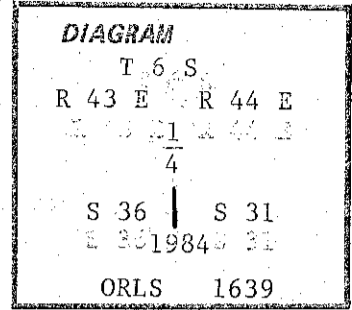

Description of corner evidence found:

NOTE: Corner position established by survey methods described on accompanying official RECORD OF SURVEY PLAT for dependent resurvey of a portion of T 6 S, R 44 E, W. M.

Description of monument and accessories established to perpetuate the original location of this corner:

Set 2 1/2" aluminum cap on 2" aluminum pipe 30" long 25" in ground with 5" proj out of ground with surrounding rock mound and 6' steel fence post alongside with sign 54-9 attached.

Aluminum cap marked as shown in corner diagram.

New bearing trees established:

A pine 8 ins dia bears N50°W, 34.4 ft marked 1/4S36 BT.

A pine 13 ins dia bears N31°E, 54.0 ft marked 1/4S31 BT.

Each new bearing tree has signs 54-3 and 54-9 attached below a 6 inch band of red paint, and a brass washer marked PLS 1639 nailed flush with BT blaze.

I hereby certify that the above described corner monument was properly established by me and witnessed by Jim DeMastus and Daryl Schuchardt on Nov. 11, 1984.

Witnessed: Jim DeMastus

**REGISTERED
PROFESSIONAL
LAND SURVEYOR**

William L. Hanley
**OREGON
JULY 14, 1973
WILLIAM L. HANLEY
1639**

Office of..... County Surveyor..... County of..... Baker
State of..... Oregon..... I hereby certify that the within instrument was filed in this office
for record on the..... day of....., 19.....

..... by
(COUNTY OFFICIAL) (DEPUTY)

FILED 4-28-86
BAKER COUNTY SURVEYOR
SURVEY NO. 6-44-53