

CERTIFIED RECORD OF LAND CORNER MONUMENTATION

X-13

**History of original corner establishment:**


Corner established by W.B. Barr under GLO contract No. 503 dated May 23, 1884.

**Surveyor General records state:**

A fir 6 inch dia for  $\frac{1}{4}$  sec cor marked 1/4S on the W side from which

A fir 5 ins dia bears N25°W, 25 lks dist marked 1/4S BT.

A fir 15 ins dia bears S15°E, 15 lks dist marked 1/4S BT.

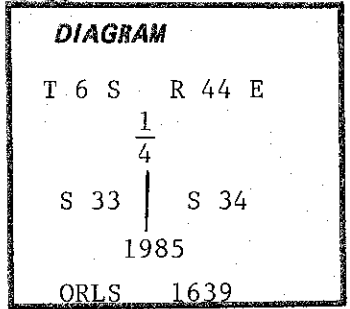

**Description of corner evidence found:**

NOTE: Corner position established by survey methods described on accompanying official RECORD OF SURVEY PLAT for dependent resurvey of a portion of T 6 S, R 44 E, W. M.

**Description of monument and accessories established to perpetuate the original location of this corner:**

Set a 2½" aluminum cap on 2" aluminum pipe 30" long 25" in ground with 5" proj. out of ground with surrounding rock mound and 6' steel fence post alongside with sign 54-9 attached.

Aluminum cap marked as shown in corner diagram.

**New bearing tree established:**

A fir 8 ins dia bears S24°E, 8.7 ft dist marked 1/4S34 BT.

A fir 10 ins dia bears N83½°W, 16.5 ft dist marked 1/4S33 BT.

Each new bearing tree has signs 54-3 and 54-9 attached below a 6 inch band of red paint, and a brass washer marked PLS 1639 nailed flush with BT blaze.

I hereby certify that the above described corner monument was properly established by me and witnessed by Jim DeMastus and Daryl Schuchardt on July 25, 1985.

Witnessed: Jim DeMastus

**REGISTERED  
PROFESSIONAL  
LAND SURVEYOR**

*William L. Hanley*

**OREGON  
JULY 14, 1978  
WILLIAM L. HANLEY  
1639**

Office of...County...Surveyor..... County of...Baker.....  
State of...Oregon....., I hereby certify that the within instrument was filed in this office  
for record on the..... day of....., 19.....

..... by .....  
(COUNTY OFFICIAL) (DEPUTY)

FILED 4-28-80  
BAKER COUNTY SURVEYOR  
SURVEY NO. 6-44-58