

CERTIFIED RECORD OF LAND CORNER MONUMENTATION

X-17

History of original corner establishment:


Corner established by W.B. Barr under GLO contract No. 503 dated May 23, 1884.

Surveyor General records state:

Set granite rock 12 x 10 x 8 ins 8 ins in ground for 1/4 sec cor marked 1/4 on the West side from which

A tamarack 8 ins dia bears S30°E, 75 lks dist marked 1/4S BT.

A fir 5 ins dia bears S50°W, 151 lks dist marked 1/4S BT.

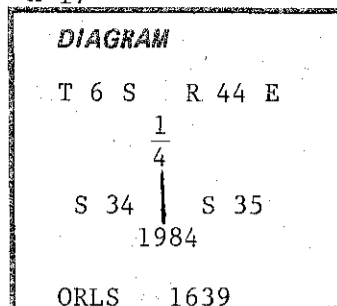

Description of corner evidence found:

Found no trace of marked stone.

A hemlock 22 ins dia bears S30°E, 75 lks dist with healed blaze. No trace of other bearing tree.

Description of monument and accessories established to perpetuate the original location of this corner:

Set 2 1/2" aluminum cap on 2" aluminum pipe 30" long 25" in ground with 5" proj out of ground with surrounding rock mound and 6' steel fence post alongside with sign 54-9 attached.

Aluminum cap marked as shown in corner diagram.

New bearing tree established:

A fir 9 ins dia bears N68°W, 58.7 ft dist marked 1/4S34 BT.

Each original bearing tree and each new bearing tree has signs 54-3 and 54-9 attached below a 6 in band of red paint, additionally each new bearing tree has a brass washer marked PLS 1639 nailed flush with BT blaze.

I hereby certify that the above described corner monument was properly established by me and witnessed by Jim DeMastus and Daryl Schuchardt on Sept. 4, 1984.

Witnessed: Jim DeMastus

REGISTERED PROFESSIONAL LAND SURVEYOR

William L. Hanley

OREGON JULY 14, 1978 WILLIAM L. HANLEY 1639

Office of County Surveyor..... County of Baker Oregon

State of....., I hereby certify that the within instrument was filed in this office for record on the..... day of....., 19.....

..... by..... (COUNTY OFFICIAL) (DEPUTY)

FILED 4-28-86

BAKER COUNTY SURVEYOR

SURVEY NO. 6-44-59