

CERTIFIED RECORD OF LAND CORNER MONUMENTATION


Y-1

History of original corner establishment:

Corner originally established by W. L. Hanley and recorded under Baker County Survey No. 7-44-11, filed Oct., 4, 1978.

Record of Survey states:

Set 5/8" x 30" rebar.

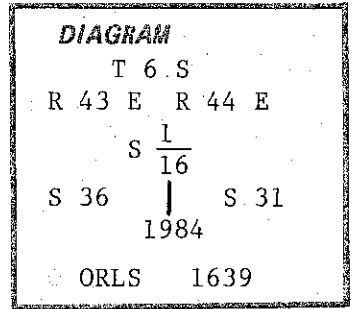

Description of corner evidence found:

Found a 5/8" x 30" rebar with a yellow plastic cap marked RPE
2808

NOTE: This found rebar bears N 54°06'35" E, 2.06 ft dist from corner position established this survey.

Description of monument and accessories established to perpetuate the original location of this corner:

Set 2½" aluminum cap on 2" aluminum pipe 30" long 25" in ground with 5" proj out of ground with surrounding rock mound and 6' steel fence post alongside with sign 54-9 attached. Buried rebar alongside aluminum capped monument.

Aluminum cap marked as shown in corner diagram.

New bearing trees established:

A fir 8 ins dia brs N44°W, 24.3 ft mkd S1/16S36 BT.
A pine 9 ins dia brs S78°E, 25.9 ft mkd S1/16S31 BT.

Each new bearing tree has signs 54-3 and 54-9 attached below a 6" band of red paint and a brass washer marked PLS 1639 nailed flush with BT blaze.

I hereby certify that the above corner monument was properly maintained to U.S.F.S. standards under my supervision and witnessed by Jim DeMastus and Daryl Schuchardt on Nov. 14, 1984.

Witnessed: Jim DeMastus

**REGISTERED
PROFESSIONAL
LAND SURVEYOR**

William L. Hanley

**OREGON
JULY 14, 1978
WILLIAM L. HANLEY
1639**

Office of County Surveyor County of Baker

State of Oregon I hereby certify that the within instrument was filed in this office for record on the day of , 19.....

..... by
(COUNTY OFFICIAL) (DEPUTY)

FILED 4-28-86
BAKER COUNTY SURVEYOR
SURVEY NO. 6-44-60