

CERTIFIED RECORD OF LAND CORNER MONUMENTATION


History of original corner establishment:

Corner originally established by W. L. Hanley and recorded under Baker County Survey No. 7-44-11, filed Oct., 4, 1978.

Record of Survey states:

Set 5/8" x 30" rebar.

YZ-1

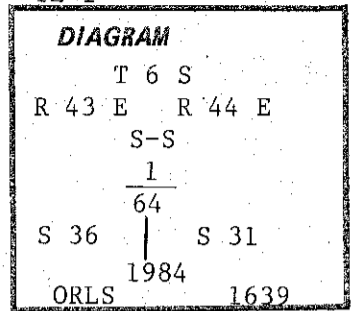

Description of corner evidence found:

Found a 5/8" x 30" rebar with a yellow plastic cap marked RPE 2808

NOTE: This found rebar bears N 68°09'07" E, 1.05 ft dist from corner position established this survey.

Description of monument and accessories I established to perpetuate the original location of this corner:

Set 2 1/2" aluminum cap on 2" aluminum pipe 30" long 25" in ground with 5" proj out of ground with surrounding rock mound and 6' steel fence post alongside with sign 54-9 attached. Buried rebar alongside aluminum monument.

Aluminum cap marked as shown in corner diagram.

New bearing trees established:

A pine 9 ins diam bears S21°E, 18.4 ft marked SS1/64S31 BT.

A fir 8 ins diam bears S83°W, 56.2 ft marked SS1/64S36 BT.

Each new bearing tree has signs 54-3 and 54-9 attached below a 6" band of red paint and a brass washer marked PLS 1639 nailed flush with BT blaze.

I hereby certify that the above corner monument was properly maintained to U.S.F.S. standards under my supervision and witnessed by Jim DeMastus and Daryl Schuchardt on Nov. 14, 1984.

Witnessed : Jim DeMastus

REGISTERED PROFESSIONAL LAND SURVEYOR

*William L. Hanley*

OREGON JULY 14, 1978 WILLIAM L. HANLEY 1639

Office of.....County Surveyor..... County of...Baker..... State of...Oregon....., I hereby certify that the within instrument was filed in this office for record on the..... day of....., 19.....

..... by ..... (COUNTY OFFICIAL) (DEPUTY)

FILED 4-28-86

BAKER COUNTY SURVEYOR

SURVEY NO. 6-44-61