


CERTIFIED RECORD OF LAND CORNER MONUMENTATION

YZ-2

History of original corner establishment:

NONE-corner established this survey.

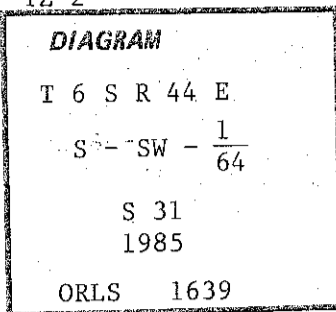

Description of corner evidence found:

None.

Description of monument and accessories established to perpetuate the original location of this corner:

Set 2½" aluminum cap on 2" aluminum pipe 30" long 25" in ground with 5" proj out of ground with surrounding rock mound and 6' steel fence post alongside with sign 54-9 attached.

Aluminum cap marked as shown in corner diagram.

New bearing trees established:

A fir 15 ins dia bears S54°W, 13.6 ft dist mkd S-SW-1/64S31 BT.

A fir 13 ins dia bears S24½°W, 46.9 ft dist mkd S-SW-1/64S31 BT.

Each new bearing tree has signs 54-3 and 54-9 attached below a 6" band of red paint and a brass washer marked PLS 1639 nailed flush with BT blaze.

I hereby certify that the above corner monument was properly maintained to U.S.F.S. standards under my supervision and witnessed by Jim DeMastus and Daryl Schuchardt on July 5, 1985.

Witnessed: Jim DeMastus



Office of... County Surveyor..... County of... Baker.....  
 State of... Oregon....., I hereby certify that the within instrument was filed in this office  
 for record on the..... day of....., 19.....

..... by .....  
 (COUNTY OFFICIAL) (DEPUTY)

FILED 4-28-86  
 BAKER COUNTY SURVEYOR  
 SUPERVISOR 6-44-62