

CERTIFIED RECORD OF LAND CORNER MONUMENTATION


Z-1

History of original corner establishment:

Corner established by W. B. Barr under GLO contract No. 503 dated May 23, 1884.

Surveyor's General records state:

A basalt stone 18 x 10 x 10, firmly planted in ground marked with 6 notches on the N S E & W edges from which:
A fir 24 ins dia bears S10°E, 35 lks dist mkd T7SR44ES6 BT.
A fir 18 ins dia bears S33°W, 36 lks dist mkd T7SR43ES1 BT.
A pine 36 ins dia bears N60°E, 92 lks dist mkd T6SR44ES31 BT.
A pine 6 ins dia bears N55°W, 77 lks dist mkd T6SR43ES36 BT.

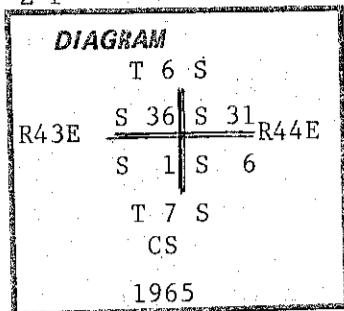

Corner REESTABLISHED by James D. Hanley in Aug. 1965.....Set 1" galvanized pipe with 2" aluminum cap marked as shown in corner diagram.

Description of corner evidence found:

Found galvanized pipe with aluminum cap as shown in corner diagram.

Found fallen snag for sec 31 BT.
No trace of other BT.

Description of monument and accessories established to perpetuate the original location of this corner:

Improved surrounding rock mound around corner monument and set a 6 foot steel fence post alongside with a sign 54-9 attached.

New bearing trees established:

A fir 9 ins dia bears N02°W, 17.0 ft mkd T6SR43ES36 BT.
A fir 8 ins dia bears N68°E, 32.7 ft mkd T6SR44ES31 BT.
A fir 13 ins dia bears S22°E, 55.8 ft mkd T7SR44ES06 BT.
A fir 10 ins dia bears S52°W, 46.1 ft mkd T7SR43ES01 BT.

Each new bearing tree has signs 54-3 and 54-9 attached below a 6 inch band of red paint and has a brass washer marked PLS 1639 nailed flush with BT blaze.

I hereby certify that the above corner monument was properly maintained to U.S.F.S. standards under my supervision and witnessed by Jim DeMastus and Daryl Schuchardt on Sept 26, 1984.

Witnessed : Jim DeMastus

**REGISTERED
PROFESSIONAL
LAND SURVEYOR**

William L. Hanley

**OREGON
JULY 14, 1978
WILLIAM L. HANLEY
1639**

Office of...County Surveyor..... County of...Baker.....
State of...Oregon....., I hereby certify that the within instrument was filed in this office
for record on the..... day of....., 19.....
..... by
(COUNTY OFFICIAL) (DEPUTY)

FILED 4-28-86
BAKER COUNTY SURVEYOR
SURVEY NO. 6-44-63