

CERTIFIED RECORD OF LAND CORNER MONUMENTATION


Z-2

History of original corner establishment:

Corner originally established by W. L. Hanley and recorded under Baker County Survey No. 7-44-11, filed Oct. 4, 1978.

Record of survey states:

Set 5/8 inch x 30 inch rebar.

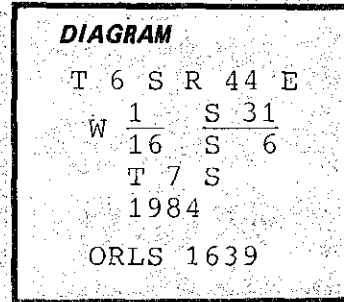

Description of corner evidence found:

Found a 5/8 inch x 30 inch rebar with yellow plastic cap marked RPE 2808

Note: This found rebar bears S 55°57'25" W, 4.12 ft dist from corner position established this survey.

Description of monument and accessories I established to perpetuate the original location of this corner:

Set a 2½ inch aluminum cap on a 2 inch aluminum pipe 30 inches long, 25 inches in the ground with 5 inches projecting out of the ground with a surrounding rock mound and a 6 foot steel fence post alongside with a sign 54-9 attached. Buried the found rebar alongside aluminum cap monument.

Aluminum cap marked as shown in corner diagram.

New bearing trees established.

A fir 9 ins diam bears S 12° E, 17.8 ft dist marked W1/16S6 BT  
A fir 7 ins diam bears N 84° E, 11.2 ft dist marked W1/16S31 BT  
Each new bearing tree has a brass washer marked PLS 1639 nailed flush with BT blaze and has signs 54-3 and 54-9 attached below a 6 inch band of red paint around.

I hereby certify that the above described corner monument was properly established by me and witnessed by Jim DeMastus and Daryl Schuchardt on Nov. 20, 1984.

Jim DeMastus

REGISTERED PROFESSIONAL LAND SURVEYOR

William L. Hanley

OREGON  
JULY 14, 1978  
WILLIAM L. HANLEY  
1639

Office of..... Surveyor..... County of..... Baker.....  
State of Oregon....., I hereby certify that the within instrument was filed in this office  
for record on the..... day of....., 19.....  
..... by .....  
(COUNTY OFFICIAL) (DEPUTY)

Form R6-7100-57 (9/71)

☆ GPO-798-276

FILED 4-28-86  
BAKER COUNTY SURVEYOR  
SURVEY NO. 6-44-64