

CERTIFIED RECORD OF LAND CORNER MONUMENTATION


Z-6

History of original corner establishment:

Corner originally established by W. L. Hanley and recorded under Baker County Survey No. 7-44-11, filed Oct., 4, 1978.

Record of Survey states:

Set 5/8" x 30" rebar.

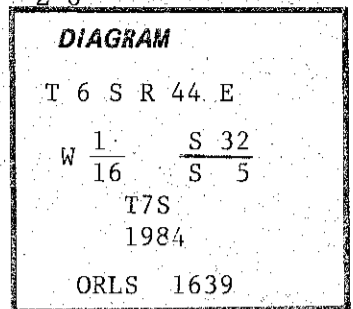

Description of corner evidence found:

Found a 5/8" x 30" rebar with yellow plastic cap marked RPE 2808

NOTE: This found rebar bears S 46°01'52" W, 1.36 ft dist from corner position established this survey.

Description of monument and accessories established to perpetuate the original location of this corner:

Set 1 1/2" aluminum cap on 2" aluminum pipe 30" long 25" in ground with 5" proj out of ground with surrounding rock mound and 6' steel fence post alongside with sign 54-9 attached.

Aluminum cap marked as shown in corner diagram.

New bearing trees established:

A fir 8 ins dia brs N02°E, 40.2 ft dist mkd W1/16S32 BT.

A spruce 16 ins dia brs S34°E, 22.5 ft dist mkd W1/16S5 BT.

Each new bearing tree has signs 54-3 and 54-9 attached below a 6" band of red paint and a brass washer marked PLS 1639 nailed flush with BT blaze.

I hereby certify that the above corner monument was properly maintained to U.S.F.S. standards under my supervision and witnessed by Jim DeMastus and Daryl Schuchardt on Nov. 7, 1985.

Witnessed : Jim DeMastus

**REGISTERED
PROFESSIONAL
LAND SURVEYOR**

William L. Hanley

**OREGON
JULY 14, 1978
WILLIAM L. HANLEY
1639**

Office of County Surveyor..... County of Baker
State of Oregon....., I hereby certify that the within instrument was filed in this office
for record on the..... day of....., 19.....

..... by
(COUNTY OFFICIAL) (DEPUTY)

FILED 4-28-86
BAKER COUNTY SURVEYOR
SURVEY NO. 6-44-66