


CERTIFIED RECORD OF LAND CORNER MONUMENTATION

Z-7

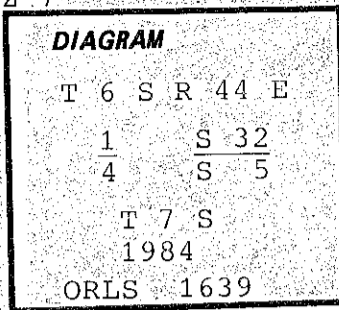

History of original corner establishment:

Corner established by W. B. Barr under GLO contract no. 503 dated May 23, 1884.

Surveyor General records state:

Set sandstone 16x10x10 ins 11 inches in ground for 1/4 sec cor marked 1/4 on the N side from which:

A fir 10 ins diam bears S 24° E, 20 lks dist marked 1/4 S BT
A fir 4 ins diam bears N 78° E, 10 lks dist marked 1/4 S BT

Description of corner evidence found:

None...This corner position has been searched by me on two occasions, in 1978 and this date, and searched by John Mitchell on at least one occasion, and searched by U.S.F.S. employee Ed Holland and the original corner and its accessories have been declared lost. Corner position established by single proportionate measurement between adjacent township line section corners.

Description of monument and accessories | established to perpetuate the original location of this corner:

Set a 2 1/2 inch aluminum cap on a 2 inch aluminum pipe 30 inches long, 25 inches in the ground with 5 inches projecting out of the ground with a surrounding rock mound and a 6 foot steel fence post alongside with a sign 54-9 attached.

Aluminum cap marked as shown in corner diagram.

New bearing trees established:

A fir 14 ins diam bears N 53° E, 37.4 ft dist marked 1/4 S 32 BT
A fir 6 ins diam bears S 89° W, 33.6 ft dist marked 1/4 S 5 BT

Each new bearing tree has a brass washer marked PLS 1639 nailed flush with BT blaze and has signs 54-3 and 54-9 attached below a 6 inch band of red paint around.

I hereby certify that the above described corner monument was properly established by me and witnessed by Jim DeMastus and Daryl Schuchardt on Nov. 8, 1984.

Jim DeMastus

**REGISTERED
PROFESSIONAL
LAND SURVEYOR**

William L Hanley

**OREGON
JULY 14, 1978
WILLIAM L. HANLEY
1639**

Office of... Surveyor County of... Baker

State of... Oregon I hereby certify that the within instrument was filed in this office for record on the..... day of....., 19.....

..... by (DEPUTY)
(COUNTY OFFICIAL)

FILED 4-28-86
BAKER COUNTY SURVEYOR
SURVEY No. 6-44-67