


CERTIFIED RECORD OF LAND CORNER MONUMENTATION

History of original corner establishment:

Post 5 ft. long 4 ins. sq. 24 ins. in ground mkd.  
Cor. No. 3 APMC Sur. No. 6 on West face from which  
Fir, 10 ins. diam. bears N 52° 30' W., 26 lks. dist.  
mkd. Cor. No. 3 APMC Sur. No. 6 BT  
Fir, 9 ins. diam. bears S 58° 45' W., 17 lks. dist.  
mkd. Cor. No. 3 APMC Sur. No. 6 BT

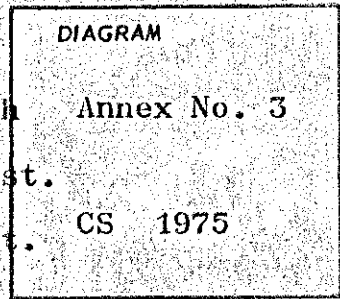

Description of corner evidence found:

Rock mound from which  
28 in. diam fir (9 ins. overgrowth) bears N 52° 30' W., 17.4 ft. dist.  
23 in. diam. fir stump with scab mark at base bears S. 58° 45' W.,  
11.2 ft. dist.

Description of monument and accessories established to perpetuate the original location of this corner

Set a 2 in. brass cap on a 1 in. iron post mkd. as shown above  
Scribed the following tree:

11 in. fir, bears N. 80° E., 44.35 ft. dist., mkd. APC No. 3 CS BT



Office of County Surveyor County of BAKER  
State of OREGON, I hereby certify that the within instrument was filed in this office  
for record on the 7 day of AUGUST, 1975.  
by William J. Hanley  
(COUNTY OFFICIAL) (DEPUTY)

BAKER COUNTY SURVEYOR  
SURVEY NO. 6-45-8