


CERTIFIED RECORD OF LAND CORNER MONUMENTATION

History of original corner establishment:

None

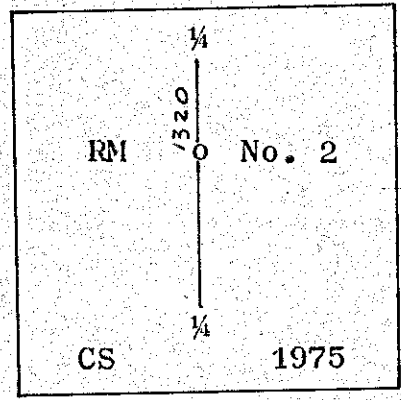


Description of corner evidence found: -

None

Description of monument and accessories established to perpetuate the original location of this corner

Set a 2 in. diam. brass cap on 1 in. iron post on mid-section line, 1320.0 feet from N 1/4 cor. of Sec. 27, T. 6 S., R. 45 E., W.M., mkd. as shown above.

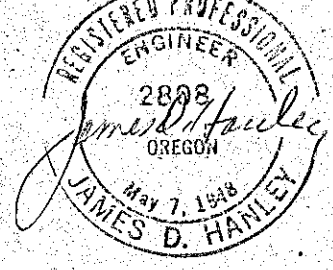

Office of COUNTY SURVEYOR County of BAKER
State of OREGON, I hereby certify that the within instrument was filed in this office
for record on the 7 day of AUGUST, 1975
by William L. Hanley
(COUNTY OFFICIAL) (DEPUTY)

BAKER COUNTY SURVEYOR
SURVEY NO. 6-45-10